

Lamar
 M 83
 4-23-81

MISSISSIPPI DEPARTMENT OF NATURAL RESOURCES
 Bureau of Land and Water Resources
 Southport Mall
 P.O. Box 10631
 Jackson, Mississippi 39209
 WATER WELL DRILLERS LOG

CODED

Griner Drilling
 Service, Inc

Lamar

4-23-81
 date well completed

Griner Drilling
 Service, Inc
 firm name

Lamar
 county well located

LANDOWNER:
 R.E. Williams
 P.O. Box 698
 Natchez, Ms 39120
 (mailing address)

description of formations
 encountered

from to

red sand

0 30

clay

30 270

sand & gravel


270 357

WELL LOCATION: 880' S + 2300' E
 of
 R. 16 E
 T. 28 N
 of
 Union
 Mineral
 Baxterville
 et al
 (distance) (direction) (nearest town)

WELL PURPOSE: oil field
 (home, irrigation, municipal supply)

WELL COMPLETION DATA:

- (1) diameter (inches) 3"
- (2) total depth (feet) 357'
- (3) static water level (feet) 110' ^{below} _{above} top of ground.
- (4) casing steel 357'
 (material), (depth)
 3" if telescope see back.
 (size)
- (5) screen 42' 315'
 (length), (depth to top)
 3" perforated
 (size), (material)
- (6) pump — 60
 (HP), (yield gpm)
 AC
 (type power)
- (7) electric log —
 (yes or no)

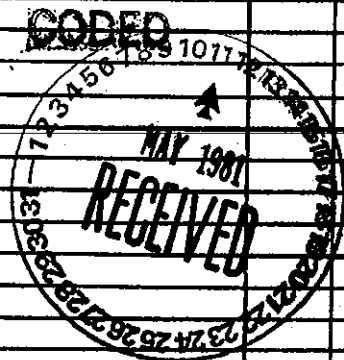

(organization running log)

(8) how well bottom plugged Orange
 peel

DRILLERS REMARKS: