	The State W	ell Report	
County: Lamar		Part 1	For Office Use Only:
Permit #:	Mississippi Department of Environmental Qualit Office of Land and Water Resources		Aquifer:
Driller: Gary Rayborn		and water Resources Box 10631	Well #: <u>M - 140</u>
1 7 1	Jackson, 1415 59209-0051		L. S. Elevation:
Date drilling completed: 52005	(601)961-5210 (601)354-6938 (fax)		E-log #:
State Law requires that this rep 30 days of completion of drilling		driller in detail and filed w	ith the Department within
30 days of completion of drilling of the well. Well Owner Information		Well	Location
Dwner NameD+DDrilling		Latitude:°'	_" Longitude:^
Mailing Address: P.O. BUX 1634		Method of Lat/Long (circle or	ne): Conventional Survey,
· · · · · · · · · · · · · · · · · · ·		USGS quad, Hand-held	GPS, Survey-grade GPS
Ferriday LA 71334 City State Zip Code		14 14 Sec_18 Twn_1 N_Rng_16 M	
Telephone No. (318) 757 - 3	274	Miles	of Bayfervill
	Well	L Data	
Purpose of Well (circle one) Home In	dustrial Public Supply	Irrigation Fish Culture	Other: RiaSupp
		1	
Date well drilling started: 520	Date	well drilling completed:	20105
If flowing, method of flow regulation: Va			
Static Water Level:feet a	bove or below (circle one)	land surface Date measured:	5-20-05
	steel tape <elecutic tape<="" td=""><td></td><td></td></elecutic>		
Hole depth: 250 Well d	epth: 250	Well grouted to a depth of	[Ofeet
•	epth: 250 Bentonite Mix		10 feet
Type of grout (circle one): Cemen	Bentonite Mix		,
Type of grout (circle one): Cement	Bentonite Mix	inches Type of casing:	DUC
Type of grout (circle one): Cemen Casing length: <u>230</u> feet Cas Screen length: <u>201</u> feet Scr	Bentonite Mix sing diameter: reen diameter:	inches Type of casing: inches Type of screen:	Puc Puc
Type of grout (circle one): Cemer Casing length: <u>230</u> feet Cas Screen length: <u>201</u> feet Scr Screen slot size: <u>020</u> inches	Bentonite Mix sing diameter: reen diameter: Setting depth: From	inches Type of casing: inches Type of screen: feet to2	PUC FUC 50 feet
Type of grout (circle one): Cemen Casing length: <u>230</u> feet Cas Screen length: <u>201</u> feet Scr	Bentonite Mix sing diameter: reen diameter: Setting depth: From	inches Type of casing: inches Type of screen: feet to2	Puc Puc
Type of grout (circle one): Cemer Casing length: <u>230</u> feet Cas Screen length: <u>201</u> feet Scr Screen slot size: <u>020</u> inches	Bentonite Mix sing diameter: reen diameter: Setting depth: From Setting depth: From travel packer Unde	inches Type of casing: inches Type of screen: feet to2	JUC PUC 50 feet hole
Type of grout (circle one): Cemer Casing length: <u>230</u> feet Cas Screen length: <u>201</u> feet Scr Screen slot size: <u>020</u> inches	Bentonite Mix sing diameter: reen diameter: Setting depth: From Setting depth: From travel packed Unde Other (describe):	inches Type of casing: inches Type of screen: feet to2 mreamed Telescoped Oper	JUC PUC 50 feet hole Natural Development
Type of grout (circle one): Cemer Casing length: <u>230</u> feet Cas Screen length: <u>201</u> feet Scr Screen slot size: <u>020</u> inches Type of completion (circle all applicable)	Bentonite Mix sing diameter: reen diameter: Setting depth: From Setting depth: From travel packer Unde Other (describe): feet. If t	inches Type of casing: inches Type of screen: feet to2 mreamed Telescoped Oper elescoped or more than one scr	JUC PUC 50 feet hole Natural Development reen, describe on back of page
Type of grout (circle one): Cemer Casing length: <u>730</u> feet Cas Screen length: <u>701</u> feet Scr Screen slot size: <u>020</u> inches Type of completion (circle all applicable) Top of lap pipe or reduction in casing: Logs run (circle all applicable). <u>Vo log r</u> Name of organization running log(s):	Bentonite Mix sing diameter: reen diameter: Setting depth: From Setting depth: From Dravel packer Unde Other (describe): feet. If t un Electric Gamma Ray	inches Type of casing: inches Type of screen: feet to2 mreamed Telescoped Oper elescoped or more than one scr y Density Sonic Neutron	JUC PUC 50 feet hole Natural Development reen, describe on back of page Other:
Type of grout (circle one): Cemen Casing length: <u>730</u> feet Cas Screen length: <u>701</u> feet Scr Screen slot size: <u>020</u> inches Type of completion (circle all applicable) Top of lap pipe or reduction in casing: Logs run (circle all applicable). <u>So log r</u> Name of organization running log(s): I certify that the well was drilled, const	Bentonite Mix sing diameter: reen diameter: Setting depth: From Setting depth: From Direct packed Unde Other (describe): feet. If t un Electric Gamma Ray	inches Type of casing: inches Type of screen: feet to2 rreamed Telescoped Oper elescoped or more than one scr y Density Sonic Neutron accordance with all applicable	JUC PUC SO feet hole Natural Development reen, describe on back of page Other:
Type of grout (circle one): Cemer Casing length: <u>730</u> feet Cas Screen length: <u>701</u> feet Scr Screen slot size: <u>020</u> inches Type of completion (circle all applicable) Top of lap pipe or reduction in casing: Logs run (circle all applicable). <u>Vo log r</u> Name of organization running log(s):	Bentonite Mix sing diameter: reen diameter: Setting depth: From Setting depth: From Direct packed Unde Other (describe): feet. If t un Electric Gamma Ray	inches Type of casing: inches Type of screen: feet to2 rreamed Telescoped Oper elescoped or more than one scr y Density Sonic Neutron accordance with all applicable	JUC PUC SO feet hole Natural Development reen, describe on back of page Other:
Type of grout (circle one): Cemen Casing length: <u>730</u> feet Cas Screen length: <u>701</u> feet Scr Screen slot size: <u>020</u> inches Type of completion (circle all applicable) Top of lap pipe or reduction in casing: Logs run (circle all applicable). To log r Name of organization running log(s): I certify that the well was drilled, const Department of Environmental Quality	Bentonite Mix sing diameter: reen diameter: Setting depth: From Setting depth: From Disconsection Setting depth: From Unde Other (describe): feet. If t un Electric Gamma Ray sructed, and completed in and/or the Mississippi De	inches Type of casing: inches Type of screen: feet to	JUC PUC SO feet hole Natural Development reen, describe on back of page Other:
Type of grout (circle one): Cemen Casing length: 230 feet Cas Screen length: 70' feet Scr Screen slot size: 020 inches Type of completion (circle all applicable) Top of lap pipe or reduction in casing: Logs run (circle all applicable). To log r Name of organization running log(s): I certify that the well was drilled, const Department of Environmental Quality	Bentonite Mix sing diameter: reen diameter: Setting depth: From Setting depth: From Setting depth: From Unde Other (describe): feet. If t un Electric Gamma Ray tructed, and completed in and/or the Mississippi Des 	inches Type of casing: inches Type of screen: feet to2 rreamed Telescoped Oper elescoped or more than one scr y Density Sonic Neutron accordance with all applicable partment of Health regulations	JUC PUC SOfeet hole Natural Development reen, describe on back of page Other:
Type of grout (circle one): Cemen Casing length: <u>730</u> feet Cas Screen length: <u>701</u> feet Scr Screen slot size: <u>020</u> inches Type of completion (circle all applicable) Top of lap pipe or reduction in casing: Logs run (circle all applicable). To log r Name of organization running log(s): I certify that the well was drilled, const Department of Environmental Quality	Bentonite Mix sing diameter: reen diameter: Setting depth: From Setting depth: From Setting depth: From Unde Other (describe): feet. If t un Electric Gamma Ray tructed, and completed in and/or the Mississippi Des 	inches Type of casing: inches Type of screen: feet to2 rreamed Telescoped Oper elescoped or more than one scr y Density Sonic Neutron accordance with all applicable partment of Health regulations	JUC PUC SO feet hole Natural Development reen, describe on back of page Other:


۲

If well telescopes please sketch below and show depths.

Ground Level

M- 140 **Description of Formations Encountered** From To 0 Chalk 05 Sana 20 20 200 250 Med San

If more than one screen, show location of each on sketch

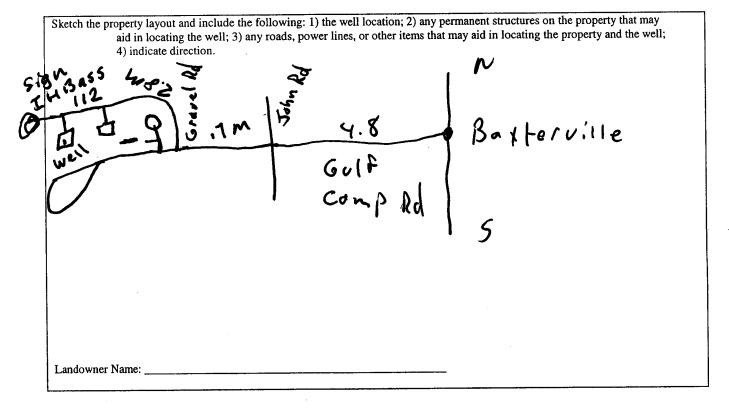

Signature of Water Well Sontractor

JUN 1 3 2005 BY: OLWR

1	ATE WELL REPORT Part 2 For Office Use Only:
	pi Department of Environmental Quality Aquifer:
Permit #:	ice of Land and Water Resources
Driller: Gary Rayborn	Jackson, MS 39289-0631 Well #: ///-/40
Date completed:5 20 05	(601)961-5210 (601)354-6938 (fax) Elevation:
This report should be prepared by the pump it	aller in detail and filed with the Department within 30 days of the
installation of pump.	
Well Owner Information	Well Location
Owner Name: DED Drilling	Latitude: Longitude:
Mailing Address: PO. Box 163	Method of Lat/Long (circle one): Conventional Survey,
	USGS quad, Hand-held GPS, Survey-grade GPS
Terriday LA 71	034 14 Sec 8 Twn N Rng 160
City State Zi	Code Distance Direction Nearest Town
Telephone No. 318, 757 - 3274	7 Miles W of Bayterville
Ритр Туре	Power Type
Circle one	Circle one
Air Lift Jet Submer	Diesel Engine Gasoline Engine Natural Ga
Bucket Piston Turbine	Electric Motor Hand Tractor PTC
Centrifugal Rotary Flowing	Vell Windmill Other (specify):
Other (specify):	Horse Power Rating of Motor:
Date Pump Installed: <u>5 - 20 - 05</u>	Setting Depth: feet
Rated Pump Capacity: Gallons 1	
Rated Pump Capacity:Ganons	
Pump Test Data	Method of Measuring Water Level
Date Well Tested: 5 - 20-05	Circle one
Static Water Level (A): <u>102</u> Feet Below L:	Air Line Electric Measuring Line Steel Tape
• •	Other (specify):
Pumping Water Level (B):Feet Below La	Surface
Drawdown [(B) – (A)]:Feet Below La	
Test Pumping Rate: Go Gallons	r Minute Well yielded GPM with a drawdown of
Duration of Pump Test (minimum 4 hours):	hoursfeet afterhours of pumpir
	· · · · · · · · · · · · · · · · · · ·
I UEDEDV CEDUTEV des des sesses statements and	e to the best of my knowledge
I HEREBY CERTIFY that the above statements are the second statement of D_{C} and D_{C}	
Rayborn Drilling Inc. Print Name of Pump Installer and Elcense No. (if app	
	REC