	State W	ell Report				
laman	Part 1		For Office Use Only:			
County: Lamar	Mississippi Department of Environmental Quality		Aquifer:			
Permit #:	Office of Land and Water Resources		Well #: M-172			
Driller: Gary Rayborn	P.O. Box 10631					
		S 39289-0631	L. S. Elevation:			
Date drilling completed: 8/10/06		961-5210				
	(601)354-6938 (fax)		E-log #:			
State Law requires that this report be prepared by the driller in detail and filed with the Department within 30 days of completion of drilling of the well.						
Well Owner Information		Well Location				
D+D Dail	lina	Latitude: ° '	_" Longitude:"			
owner runne		Lautude;	_ Longitude			
Mailing Address: PoBox 1634 Method of La		Method of Lat/Long (circle or	ne): Conventional Survey,			
,			S quad, Hand-held GPS, Survey-grade GPS			
Ferriday LA 71334 City State Zip Code		1/41/4 Sec19Twn1NRng16_ W				
City St	ate Zip Code	Distance Direction	Nearest Town			
Telephone No. (318) 757- 32	274	Miles	of Baxterville			
	Well	Data				
Purpose of Well (circle one) Home Industrial Public Supply Irrigation Fish Culture Other: Rig Supply						
Date well drilling started: 81006 Date well drilling completed: 81006						
If flowing, method of flow regulation: Valve Other (describe)						
Static Water Level: 90 feet above of below circle one) land surface Date measured: 81006						
Method of Measurement (circle one) steel tape electric tape air line other:						
Hole depth: 240' Well depth: 240' Well grouted to a depth of 10 feet						
Type of grout (circle one): Cement Bentonite Mix						
Casing length: 220 feet Casing diameter: 4! inches Type of casing: PVC						
Screen length: 20 feet Screen diameter: 4" inches Type of screen: PVC						
Screen slot size: 1020 inches Setting depth: From 220 feet to 240 feet						
Type of completion (circle all applicable): Gravel packed Underreamed Telescoped Open hole Natural Development						
Other (describe):						
Top of lap pipe or reduction in casing:feet. If telescoped or more than one screen, describe on back of page						
Logs run (circle all applicable): No log run Electric Gamma Ray Density Sonic Neutron Other:						
Name of organization running log(s):						
Department of Environmental Quality and/or the Mississippi Department of Health regulations and state laws.						
RAYBORN DRULING INC 0-60						

Print Name of Water Well Contractor and License No.

Signature of Water Well Contractor


If well telescopes please sketch below and show depths.

Ground Level

Description of Formations Encountered	From	To
CHALK	0	10
SAND	10	60
CHALK	60	180
Fine SANd	180	200
MED SAND	200	240

If more than one screen, show location of each on sketch

Sketch the property layout and include the following: 1) the well location; 2) any permanent structures on the property that may aid in locating the well; 3) any roads, power lines, or other items that may aid in locating the property and the well; 4) indicate direction.

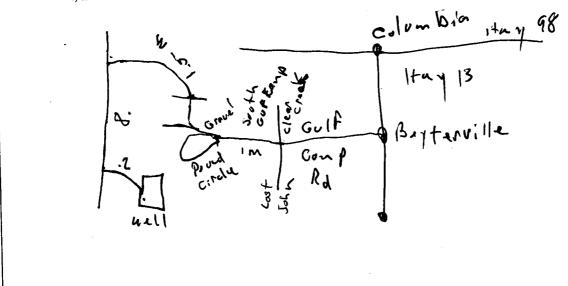

Landowner Name: \_\_\_\_\_

Signature of Water Well Contractor

RECEIVED
SEP 0 8 2006

BY: OLWR

## STATE WELL REPORT

## Part 2

Lamar Pump Installer's Completion Report
Mississippi Department of Environmental Quality County: Office of Land and Water Resources Permit #: P.O. Box 10631 Jackson, MS 39289-0631 (601)961-5210

For Office Use Only: Aquifer: Elevation:

Date completed:		I-6938 (fax)	llevation:	
This report should be prepared by t	ᅴ he pump installer in detai	and filed with the Department w	ithin 30 days of the	
installation of pump.  Well Owner Information		Well Location		
Owner Name: D+D Drilling		Latitude:Longitude:		
Mailing Address: P. 0. Box 1634		Method of Lat/Long (circle one): Conventional Survey,		
		USGS quad, Hand-he	ld GPS, Survey-grade GPS	
Ferriday LA 71334 City State Zip Code		1414 Sec19 _TwnINRngIGW_		
City State Zip Code		Distance Direction Nearest Town		
Telephone No. (318) 757-3274		of Baxterville		
Pump Type Circle one		Power Type Circle one		
Air Lift Jet	Submersible	Diesel Engine Gasoline E	Engine Natural Gas	
Bucket Piston	Turbine	Electric Motor Hand	Tractor PTO	
Centrifugal Rotary	Flowing Well	•	ecify):	
Other (specify):		Horse Power Rating of Motor:5		
Date Pump Installed: 81106		Setting Depth: 1 4	feet	
Rated Pump Capacity: 60	Gallons Per Minute	Number of Stages:	ł	
Pump Test Data		Method of Measuring Water Level Circle one		
Date Well Tested: 8 11 06				
Static Water Level (A): 90 Feet Below Land Surface		Air Line Electric Measur	ring Line Steel Tape	
Pumping Water Level (B):Fe		Other (specify):		
Drawdown [(B) – (A)]:Feet Below Land Surface		For flowing well, measured shut	in head:feet	
Test Pumping Rate: Gallons Per Minute		Well yielded 40 GPM with a drawdown of		
Duration of Pump Test (minimum 4 hou	rs):hours	feet afterhours of pumping		
I HEREBY CERTIFY that the above statements are true to the best of my knowledge.				
GARY Ray born 0-60  Print Name of Pump Installer and License No. (if applicable)  Signature of Pump Installer				
Print Name of Pump Installer and License No. (if applicable)  Signature of Pump Installer  Signature of Pump Installer				

RECEIVED

SEP 0 8 2006

BY: OLWR