

# State Well Report

Part 1

Mississippi Department of Environmental Quality  
Office of Land and Water Resources  
P.O. Box 10631  
Jackson, MS 39289-0631  
(601)961-5210  
(601)354-6938 (fax)

For Office Use Only:

Aquifer: \_\_\_\_\_  
Well #: M-174  
L. S. Elevation: \_\_\_\_\_  
E-log #: \_\_\_\_\_

County: Lamar  
Permit #: \_\_\_\_\_  
Driller: Gary Rayborn  
Date drilling completed: 8/25/06

State Law requires that this report be prepared by the driller in detail and filed with the Department within 30 days of completion of drilling of the well.

Well Owner Information	Well Location
Owner Name: <u>D + D Drilling, Inc</u>	Latitude: _____ Longitude: _____
Mailing Address: <u>P.O. Box 1634</u>	Method of Lat/Long (circle one): Conventional Survey, USGS quad, Hand-held GPS, Survey-grade GPS
<u>Ferriday, LA 71334</u>	<u>1/4</u> <u>1/4</u> Sec <u>33</u> Twn <u>1N</u> Rng <u>16W</u>
City State Zip Code	Distance Direction Nearest Town
Telephone No. ( <u>318</u> ) <u>757-3274</u>	<u>2</u> Miles <u>W</u> of <u>Baxterville</u>

Well Data

Purpose of Well (circle one) Home Industrial Public Supply Irrigation Fish Culture  Other: Rig Supply

Date well drilling started: 8-25-2006 Date well drilling completed: 8-25-2006

If flowing, method of flow regulation: Valve \_\_\_\_\_ Other (describe) \_\_\_\_\_

Static Water Level: 85' feet above or below (circle one) land surface Date measured: 8-25-2006

Method of Measurement (circle one) steel tape  electric tape air line other: \_\_\_\_\_

Hole depth: 280 Well depth: 280 Well grouted to a depth of 10 feet

Type of grout (circle one):  Cement Bentonite Mix

Casing length: 260 feet Casing diameter: 4" inches Type of casing: PVC

Screen length: 20 feet Screen diameter: 4" inches Type of screen: PVC

Screen slot size: .020 inches Setting depth: From 260 feet to 280 feet

Type of completion (circle all applicable):  Gravel packed Underreamed Telescoped Open hole Natural Development

Other (describe): \_\_\_\_\_

Top of lap pipe or reduction in casing: \_\_\_\_\_ feet. If telescoped or more than one screen, describe on back of page

Logs run (circle all applicable):  No log run Electric Gamma Ray Density Sonic Neutron Other: \_\_\_\_\_

Name of organization running log(s): \_\_\_\_\_

I certify that the well was drilled, constructed, and completed in accordance with all applicable requirements of the Mississippi Department of Environmental Quality and/or the Mississippi Department of Health regulations and state laws.

**RAYBORN DRILLING, INC.**

0-60

Print Name of Water Well Contractor and License No.

Signature of Water Well Contractor

RECEIVED  
SEP 27 2006  
BY: OLWR

M-174

If well telescopes please sketch below and show depths.

Ground Level \_\_\_\_\_


Description of Formations Encountered

From To

Clay	0	40
Sand/clay	40	130
Clay	130	230
Sand	230	280

If more than one screen, show location of each on sketch

Sketch the property layout and include the following: 1) the well location; 2) any permanent structures on the property that may aid in locating the well; 3) any roads, power lines, or other items that may aid in locating the property and the well; 4) indicate direction.

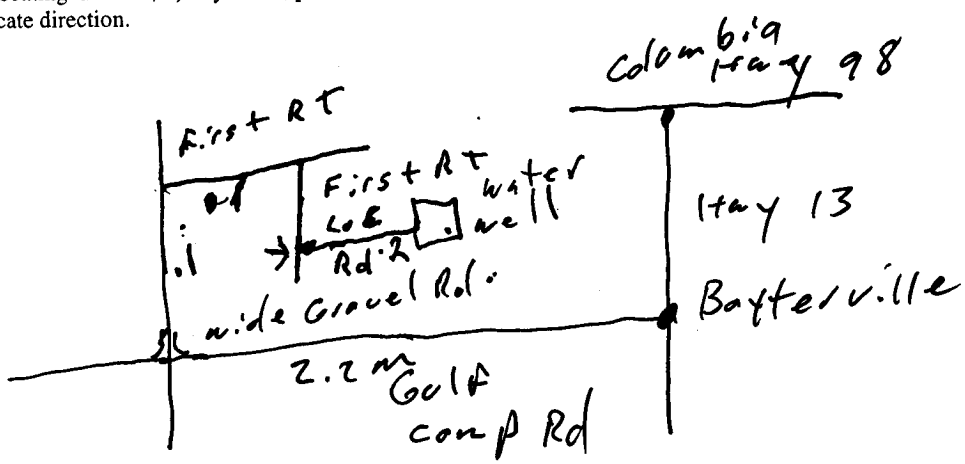

Landowner Name: \_\_\_\_\_

Signature of Water Well Contractor \_\_\_\_\_

RECEIVED  
SEP 27 2006  
BY: OLWR

# STATE WELL REPORT

## Part 2

**Pump Installer's Completion Report**  
 Mississippi Department of Environmental Quality  
 Office of Land and Water Resources  
 P.O. Box 10631  
 Jackson, MS 39289-0631  
 (601)961-5210  
 (601)354-6938 (fax)

For Office Use Only:

Aquifer: \_\_\_\_\_

Well #: M-174

Elevation: \_\_\_\_\_

County: Lamar  
 Permit #: \_\_\_\_\_  
 Driller: Gary Rayborn  
 Date completed: 8/25/06

**This report should be prepared by the pump installer in detail and filed with the Department within 30 days of the installation of pump.**

Well Owner Information	Well Location
Owner Name: <u>D+D Drilling, Inc</u>	Latitude: _____ Longitude: _____
Mailing Address: <u>P.O. Box 1634</u>	Method of Lat/Long (circle one): Conventional Survey, USGS quad, Hand-held GPS, Survey-grade GPS
<u>Ferriday, LA 71373</u> City State Zip Code	_____ 1/4 _____ 1/4 Sec <u>33</u> Twn <u>1N</u> Rng <u>16W</u>
Telephone No. <u>318) 757-3274</u>	Distance Direction Nearest Town <u>2</u> Miles <u>W</u> of <u>Baxterville</u>

Pump Type Circle one	Power Type Circle one
Air Lift <input type="checkbox"/> Jet <input type="checkbox"/> <b>Submersible</b> <input checked="" type="checkbox"/>	Diesel Engine <input type="checkbox"/> Gasoline Engine <input type="checkbox"/> Natural Gas <input type="checkbox"/>
Bucket <input type="checkbox"/> Piston <input type="checkbox"/> Turbine <input type="checkbox"/>	<b>Electric Motor</b> <input checked="" type="checkbox"/> Hand <input type="checkbox"/> Tractor PTO <input type="checkbox"/>
Centrifugal <input type="checkbox"/> Rotary <input type="checkbox"/> Flowing Well <input type="checkbox"/>	Windmill <input type="checkbox"/> Other (specify): _____
Other (specify): _____	Horse Power Rating of Motor: <u>5HP</u>
Date Pump Installed: <u>8/25/06</u>	Setting Depth: <u>147</u> feet
Rated Pump Capacity: <u>60</u> Gallons Per Minute	Number of Stages: <u>14</u>

Pump Test Data	Method of Measuring Water Level Circle one
Date Well Tested: <u>8/25/06</u>	Air Line <input type="checkbox"/> <b>Electric Measuring Line</b> <input checked="" type="checkbox"/> Steel Tape <input type="checkbox"/>
Static Water Level (A): <u>85</u> Feet Below Land Surface	Other (specify): _____
Pumping Water Level (B): _____ Feet Below Land Surface	For flowing well, measured shut in head: _____ feet
Drawdown [(B) - (A)]: _____ Feet Below Land Surface	Well yielded <u>60</u> GPM with a drawdown of _____ feet after _____ hours of pumping
Test Pumping Rate: <u>60</u> Gallons Per Minute	
Duration of Pump Test (minimum 4 hours): _____ hours	

I HEREBY CERTIFY that the above statements are true to the best of my knowledge.

Gary Rayborn 0-60  
 Print Name of Pump Installer and License No. (if applicable)

[Signature]  
 Signature of Pump Installer

**RECEIVED**  
 SEP 27 2006  
 BY: OLWR