· · · · · · · · · · · · · · · · · · ·	- State W	ell Report			
County: Lamar	P	art 1	For Office Use Only:		
Permit #:		t of Environmental Quality nd Water Resources	Aquifer:		
Driller: Gary Rayborn	P.O. E	Box 10631	Well #: <u>M- 18</u>		
Date drilling completed: 9115106		IS 39289-0631 961-5210	L. S. Elevation:		
	1	4-6938 (fax)	E-log #:		
State Law requires that this rep	oort be prepared by the	driller in detail and filed w	with the Department within		
30 days of completion of drilling of the well. Well Owner Information		Wel	I Location		
Owner Name D+D Drilling, Inc.		Latitude:°,' Longitude:°,'"			
Mailing Address: P.O.Box 1634		Method of Lat/Long (circle o	ne): Conventional Survey,		
		USGS quad; Hand-held GPS, Survey-grade GPS			
Ferriday LA 71334		<u>14 14 Sec 6 Twn IN Rng 16W</u>			
City State Zip Code		Distance Direction Nearest Town 3_Miles of Baxtery, 11e			
Telephone No. (318) 151- 3	Felephone No. (318) 757 - 3274		of Baxterville		
Well Data					
Purpose of Well (circle one) Home Industrial Public Supply Irrigation Fish Culture Other: Rig Supply					
Date well drilling started: 9/14/0	Date Date	well drilling completed:	115/06		
If flowing, method of flow regulation: Valve Other (describe)					
Static Water Level: <u>65</u> feet above of below (circle one) land surface Date measured: <u>91506</u>					
Method of Measurement (circle one) steel tape electric tape air line other:					
Hole depth: 180 Well depth: 180 Well grouted to a depth of 10 feet					
Type of grout (circle one): Cement Bentonite Mix					
Casing length: <u>160</u> feet Casing diameter: <u>4</u> inches Type of casing: <u>PVC</u>					
Casing length:					
Screen length: <u>20</u> feet Screen diameter: <u>1</u> inches Type of screen. <u>180</u> feet					
Type of completion (circle all applicable): Gravel packed Underreamed Telescoped Open hole Natural Development					
		<u></u>			
Top of lap pipe or reduction in casing:feet. If telescoped or more than one screen, describe on back of page					
Logs run (circle all applicable): No log r	run] Electrić Gamma Ray	Density Sonic Neutron	Other:		
Name of organization running log(s):					
I certify that the well was drilled, const Department of Environmental Quality	end/or the Mississioni De	accordance with all applicable	s and state laws.		
Department of Environmental Quality RAYBORN DRILLING, IN	and of the mississippi De	parament of frequent regulation			
·	0-60				
Print Name of Water Well Contractor an	d License No.	Signature	of Water Wel PECEIVED		
L			OCT 0 4 2006		
			BY: OLWR		

٠

3

,


M- [8/

If well telescopes please sketch below and show depths.

Ground Level

Description of Formations Encountered	From	10
SAnd	0	15
3 And and clay mix	15	80
Chaik	90	140
Sand	140	180
		<u> </u>
		<u> </u>

If more than one screen, show location of each on sketch

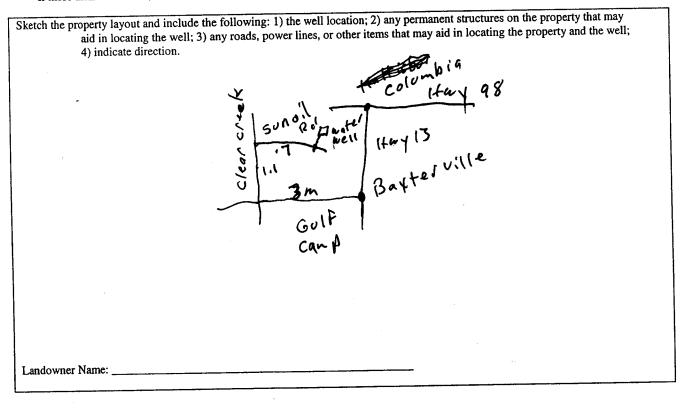

Signature of Water Vell Contractor

RECEIVED OCT 0 4 2006 BY: OLWR

 STATE WF	ELL REPORT
County: Lamar Permit #: Permit #: Driller: Gary Raybor Dista completed: 91151016	For Office Use Only: art 2 For Office Use Only: according to the point of Environmental Quality Aquifer: according to the point of Environmental Quality Aquifer: according to the point of Environmental Quality M - 18/ Box 10631 Well #: 1-18/ 961-5210 Elevation:
This report should be prepared by the pump installer in detai installation of pump.	
Well Owner Information Owner Name: D+D Drilling, Inc. Mailing Address: P.O.BOX 1634 <u>Ferriday LA 71334</u> City State Zip Code Telephone No. (<u>318, 757 - 3274</u>	Well Location Latitude: Method of Lat/Long (circle one): Conventional Survey, USGS quad, Hand-held GPS, Survey-grade GPS 14 14 Sec TwnIN RngIW Distance Direction Nearest Town 3_Miles
Pump Type Circle one Air Lift Jet Submersible Bucket Piston Turbine Centrifugal Rotary Flowing Well Other (specify):	Power Type Circle one Diesel Engine Gasoline Engine Natural Gas Electric Motor Hand Tractor PTO Windmill Other (specify):
Pump Test Data Date Well Tested: 9 - 15 - 200 6 Static Water Level (A): 65 Feet Below Land Surface Pumping Water Level (B): Feet Below Land Surface Drawdown [(B) - (A)]: Feet Below Land Surface Test Pumping Rate: 60 Gallons Per Minute Duration of Pump Test (minimum 4 hours): hours	Method of Measuring Water Level Circle one Air Line Electric Measuring Line Steel Tape Other (specify):
I HEREBY CERTIFY that the above statements are true to the best <u>Gary Rayborn</u> <u>O-60</u> Print Name of Pump Installer and License No. (if applicable)	of my knowledge. Signature of Pump Installer RECEIVED

BY: OLWR

÷,

.