<u>2.</u>	State Well Repor	•t For Office Use Only:
County: Lamar	Part 1	
•	Mississippi Department of Environm Office of Land and Water Res	ental Quality Aquifer:
Permit #:	P.O. Box 10631	well #: M- 182
Driller: Gary Rayborn	Jackson, MS 39289-063	1 L. S. Elevation:
Date drilling completed: 10-4-06	(601)961-5210 (601)354-6938 (fax)	E-log #:
State Law requires that this re	port be prepared by the driller in de	tail and filed with the Department within
30 days of completion of drillin Well Owner Inform	g of the well.	Well Location
_		' Longitude:^'
Owner Name D+D Dril		Longitude:
Mailing Address: P.O. Box	1634 Method of L	at/Long (circle one): Conventional Survey,
		quad, Hand-held GPS, Survey-grade GPS
Forthered		<u>14 Sec 21 Twn IN Rng 160</u>
Ferriday L	tate Zip Code	
eny	Distance	Direction of Baxeryille
Telephone No. (318) 757-327	M	iles of Day Trvi ile
	Well Data	- · · · · · · · · · · · · · · · · · · ·
	Latin D blie Georgia Indention	Fich Culture Tother Rice Succel
•		Fish Culture Other: Rig Supply
Date well drilling started:	-06 Date well drilling co	ompleted: 10-4-06
	alve Other (describe)	
•		
•	above or below circle one) land surface	
Static Water Level:feet	above or below (circle one) land surface	Date measured: 10-4-06
Static Water Level:feet Method of Measurement (circle one)	above or below circle one) land surface steel tape electric tape air line	Date measured: 10-4-06
Static Water Level:feet Method of Measurement (circle one)	above or below (circle one) land surface	Date measured: 10-4-06
Static Water Level:feet Method of Measurement (circle one) Hole depth:Well of	above or below circle one) land surface steel tape electric tape air line	Date measured: 10-4-06
Static Water Level: <u>90'</u> feet Method of Measurement (circle one) Hole depth: <u>260'</u> Well of Type of grout (circle one): Cement	above or below circle one) land surface steel tape electric tape air line lepth: 260' Well grout Bentonite Mix	Date measured: 10-4-06 other: ed to a depth offeet
Static Water Level: <u>90'</u> feet Method of Measurement (circle one) Hole depth: <u>260'</u> Well of Type of grout (circle one): <u>Cement</u> Casing length: <u>240</u> feet Ca	above or below circle one) land surface steel tape electric tape air line lepth: 260' Well grout Bentonite Mix sing diameter: 4 inches	Date measured: 10-4-06 other: ed to a depth offeet Type of casing:PVC
Static Water Level: 90' feet Method of Measurement (circle one) Hole depth: 260' Well of Type of grout (circle one): Cement Casing length: 240 feet Ca	above or below circle one) land surface steel tape electric tape air line lepth: 260' Well grout Bentonite Mix sing diameter: 4 inches	Date measured: 10-4-06 other: ed to a depth offeet
Static Water Level:feet Method of Measurement (circle one) Hole depth: Well of Type of grout (circle one): Cement Casing length: feet Ca Screen length: feet Sc	above or below circle one) land surface steel tape electric tape air line lepth: 260' Well grout Bentonite Mix sing diameter: 4 inches reen diameter: 4 inches	Date measured: 10-4-06 other: ed to a depth offeet Type of casing: Type of screen:PVC
Static Water Level: 90' feet Method of Measurement (circle one) Hole depth: 260' Well of Type of grout (circle one): Cement Casing length: 240 feet Ca Screen length: 20 feet So Screen slot size: 020 inches	above or below circle one) land surface steel tape electric tape air line lepth: 260' Well grout Bentonite Mix sing diameter: 4 inches reen diameter: 4 inches Setting depth: From 240	Date measured: 10-4-06 other: ed to a depth offeet Type of casing: Type of screen: feet tofeet
Static Water Level:feet Method of Measurement (circle one) Hole depth: Well of Type of grout (circle one): Cement Casing length: feet Ca Screen length: feet Sc	above or below circle one) land surface steel tape electric tape air line lepth: 260' Well grout Bentonite Mix sing diameter: 4 inches reen diameter: 4 inches Setting depth: From 240	Date measured: 10-4-06 other: ed to a depth offeet Type of casing: Type of screen:PVC
Static Water Level: 90' feet Method of Measurement (circle one) Hole depth: 260' Well of Type of grout (circle one): Cement Casing length: 240 feet Ca Screen length: 20 feet So Screen slot size: 020 inches	above or below circle one) land surface steel tape electric tape air line lepth: 260' Well grout Bentonite Mix sing diameter: 4 inches reen diameter: 4 inches Setting depth: From 240): Gravel packed Underreamed Te	Date measured: 10-4-06 other: ed to a depth offeet Type of casing: Type of screen: feet tofeet
Static Water Level:feet Method of Measurement (circle one) Hole depth: Well of Type of grout (circle one): Cement Casing length: feet Ca Screen length: feet Sc Screen slot size: feet Sc Type of completion (circle all applicable	above or below circle one) land surface steel tape electric tape air line lepth:260' Well grout Bentonite Mix sing diameter: inches reen diameter: inches Setting depth: From240): Gravel packed Underreamed Te Other (describe):	Date measured: 10-4-06 other: ed to a depth offeet Type of casing: Type of screen: feet to feet to Lescoped Open hole Natural Developmen
Static Water Level:feet Method of Measurement (circle one) Hole depth: Well of Type of grout (circle one): Cement Casing length: feet Ca Screen length: feet Sc Screen slot size: feet Sc Screen slot size: inches Type of completion (circle all applicable	above or below circle one) land surface steel tape electric tape air line lepth: 260' Well grout Bentonite Mix sing diameter: 4 inches reen diameter: 4 inches Setting depth: From 240): Gravel packed Underreamed Te Other (describe):	Date measured: 10-4-06 other: ed to a depth offeet Type of casing:PVC Type of screen:PVC feet to260feet lescoped Open hole Natural Developmen more than one screen, describe on back of page
Static Water Level:feet Method of Measurement (circle one) Hole depth: Well of Type of grout (circle one): Cement Casing length: feet Ca Screen length: feet Sc Screen slot size: feet Sc Screen slot size: inches Type of completion (circle all applicable	above or below circle one) land surface steel tape electric tape air line lepth: 260' Well grout Bentonite Mix sing diameter: 4 inches reen diameter: 4 inches Setting depth: From 240): Gravel packed Underreamed Te Other (describe):	Date measured: 10-4-06 other: ed to a depth offeet Type of casing: Type of screen: feet to feet to Lescoped Open hole Natural Developmen
Static Water Level:	above or below circle one) land surface steel tape electric tape air line lepth: 260' Well grout Bentonite Mix sing diameter: 4 inches reen diameter: 4 inches Setting depth: From 240): Gravel packed Underreamed Te Other (describe):	Date measured: 10-4-06 other: ed to a depth offeet Type of casing:PVC Type of screen:PVC feet to260feet lescoped Open hole Natural Developmen more than one screen, describe on back of page
Static Water Level:feet Method of Measurement (circle one) Hole depth: Well of Type of grout (circle one): Cement Casing length: feet Ca Screen length: feet Sc Screen slot size: feet Sc Screen slot size: inches Type of completion (circle all applicable Top of lap pipe or reduction in casing: Logs run (circle all applicable): No log Name of organization running log(s):	above or below circle one) land surface steel tape electric tape air line lepth: 260' Well grout Bentonite Mix sing diameter: 4 inches reen diameter: 4 inches setting depth: From 240 Conter (describe): 7 feet. If telescoped or no run Electric Gamma Ray Density S	Date measured: 10-4-06 other:
Static Water Level:	above or below circle one) land surface steel tape electric tape air line lepth:260' Well grout Bentonite Mix sing diameter: inches reen diameter: inches setting depth: From240): Gravel packed Underreamed Tec Other (describe): feet. If telescoped or no run Electric Gamma Ray Density S tructed, and completed in accordance with	Date measured: 10-4-06 other:
Static Water Level:	above or below circle one) land surface steel tape electric tape air line lepth: 260' Well grout Bentonite Mix sing diameter: 4 inches reen diameter: 4 inches setting depth: From 240 Conter (describe): 7 feet. If telescoped or no run Electric Gamma Ray Density S	Date measured: 10-4-06 other:
Static Water Level:	above or below circle one) land surface steel tape electric tape air line lepth:260' Well grout Bentonite Mix sing diameter: inches reen diameter: inches Setting depth: From240 Setting depth: From240 (Gravel packed Underreamed Tec Other (describe): feet. If telescoped or no run Electric Gamma Ray Density S tructed, and completed in accordance with and/or the Mississippi Department of H	Date measured: 10-4-06 other:
Static Water Level:	above or below circle one) land surface steel tape electric tape air line lepth: 260' Well grout Bentonite Mix sing diameter: 4 inches reen diameter: 4 inches Setting depth: From 240 (Gravel packed Underreamed Tex Other (describe):	Date measured: 10-4-06 other:

If well telescopes please sketch below and show depths.




M-182

Description of Formations Encountered	From	To
Clay	0	45
SAND	<u> </u>	65
Clay	65	za
SAND	200	24(
Pea Gravel	24 0	26
		+
		1

If more than one screen, show location of each on sketch

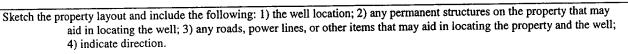

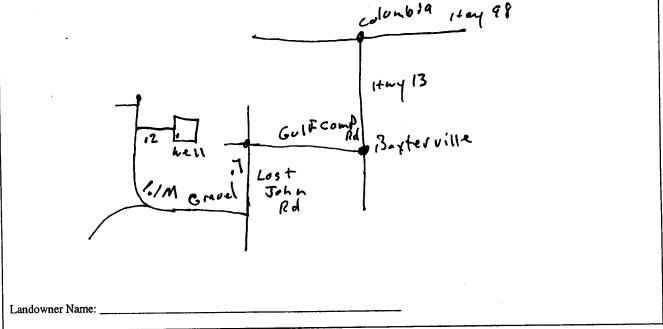

RECEIVED NOV US 2008 BY CLUBER

installation of pump. Well Ov Owner Name: D+D Mailing Address: P.O Ferri City Telephone No. (318) 1 H Air Lift Je Bucket Pi Centrifugal Rd	born 26 prepared by the pump in wher Information Drilling, 7 . Box 1634 day, LA 71 State Z 57 - 3274 Pump Type Circle one	Enc. I M 334 ip Code D	10631 39289-0631 5210 938 (fax) ad filed with the	Well g (circle one quad, Hand- ¹ 4 Sec_21 Direction W of Pow Cir	Elevation: t within 30 da Location Longitude: e): Convention held GPS, Su Twn Nearest T	nal Survey, 1rvey-grade G Rng] [ot 'own
This report should be p Well OV Owner Name: D+D Mailing Address: P.O Ferri City Telephone No. (318) T Air Lift Je Bucket Pi Centrifugal Rd	prepared by the pump in wher Information Drilling, 7 Box 1634 day, LA 717 State Z 57 - 3274 Pump Type Circle one st Subment	nstaller in detail ar	ad filed with the	Well g (circle one quad, Hand- ¹ 4 Sec_21 Direction W of Pow Cir	Location Longitude: e): Convention held GPS, Su TwnN Nearest T Mearest T err Type rcle one	nal Survey, nrvey-grade G <u>Rng</u> 160 own wille
installation of pump. Well Ov Owner Name: D+D Mailing Address: P.O Ferri City Telephone No. (318) 7 H Air Lift Je Bucket Pi Centrifugal Ro	wher information Drilling, 7 Box 1634 day, LA 717 State 72 57 - 3274 Pump Type Circle one st Subment	Enc. I M 334 ip Code D	Latitude: fethod of Lat/Lon USGS of ^{1/4} Distance I Miles Diesel Engine	Well g (circle one quad, Hand- ¹ 4 Sec_21 Direction W of Pow Cir	Location Longitude: e): Convention held GPS, Su TwnN Nearest T Mearest T err Type rcle one	nal Survey, nrvey-grade G <u>Rng</u> 160 own wille
Owner Name: D+D Mailing Address: P.O Ferri City Telephone No. (318) 1 H Air Lift Je Bucket Pi Centrifugal Ro	Drilling, 7 Box 1634 day, LA 71 State 7 57 - 3274 Pump Type Circle one t Subment	ip Code	fethod of Lat/Lon USGS of ^{1/4} Distance I Miles Diesel Engine	ng (circle one quad, Hand- ¼ Sec <u>21</u> Direction Wof Pow Cir	e): Convention held GPS, Su TwnN Nearest T Mearest T f wer Type rcle one	nal Survey, nrvey-grade G <u>Rng</u> 160 'own wille
Mailing Address: P.O Ferric City Telephone No. (318) 7 H Air Lift Je Bucket Pi Centrifugal Ro	. Box 1634 day, LA 71 State Z 57 - 3274 Pump Type Circle one st Submen	ip Code	fethod of Lat/Lon USGS of ^{1/4} Distance I Miles Diesel Engine	ng (circle one quad, Hand- ¼ Sec <u>21</u> Direction Wof Pow Cir	e): Convention held GPS, Su TwnN Nearest T Mearest T f wer Type rcle one	nal Survey, nrvey-grade G <u>Rng</u> 160 own wille
Ferri City Telephone No. (318) 7 H Air Lift Je Bucket Pi Centrifugal Ro	day, LA 71 State Z 57 - 3274 Pump Type Circle one st Submer	334 ip Code	USGS of	quad, Hand- ¹ 4 Sec <u>21</u> Direction <u>W</u> of <u>Pow</u> Cin	held GPS, Su Twn_ IN Nearest T Bax-ter ver Type rcle one	urvey-grade G Rng 66 Yown ille
Telephone No. (318) 7 H Air Lift Je Bucket Pi Centrifugal Ro	57 - 3274 Pump Type Circle one at Submer	rsible	¹ 4 Distance I Miles Diesel Engine	¹ 4 Sec_21 Direction W of Pow Cir	TwnNearest T Baxer Baxer ver Type rcle one	I_Rng.160
Telephone No. (318) 7 H Air Lift Je Bucket Pi Centrifugal Ro	57 - 3274 Pump Type Circle one at Submer	rsible	Distance I <u>4</u> Miles Diesel Engine	Direction <u>W</u> of Pow Cir	Nearest T Bax-er ver Type rcle one	own rville
Telephone No. (318) 7 H Air Lift Je Bucket Pi Centrifugal Ro	57 - 3274 Pump Type Circle one at Submer	rsible	<u>4</u> Miles	W of Pow Cit	ver Type rcle one	wille
Air Lift Je Bucket Pi Centrifugal Ro	Pump Type Circle one st Submer	rsible	Diesel Engine	Pow Cir	ver Type rcle one	
Air Lift Je Bucket Pi Centrifugal Ro	Pump Type Circle one st Submer			Cir	rcle one	Natural
Air Lift Je Bucket Pi Centrifugal Ro	Circle one st Submer			Cir	rcle one	Natural
Bucket Pi Centrifugal Ro				Gasolin	e Engine	Natural
Centrifugal Ro	iston Turbine					
Ũ			Electric Motor	Hand		Tractor I
	otary Flowin	g Well V	Vindmill	Other (specify):	
Other (specify):		F	Iorse Power Ratir	ng of Motor:	5HP	<u></u>
Date Pump Installed:			Setting Depth:			
Rated Pump Capacity:		Per Minute N	Number of Stages	. 14		
Rated Pump Capacity:	Ganons			•		
Pu	mp Test Data		Me		asuring Wate	r Level
Date Well Tested:	0-10-06		_	Ci	ircle one	
Static Water Level (A):			Air Line	Electric Meas	suring Line	Steel Tap
			Other (specify):			
Pumping Water Level (B):				<u> </u>		
Drawdown [(B) – (A)]:			For flowing well,			
Test Pumping Rate:	Gallons	Per Minute	Well yielded	60	GPM with	a drawdown c
Duration of Pump Test (min	nimum 4 hours):	hours		_feet after _		_hours of pur
<u> </u>	·					
I HEREBY CERTIFY that t		4mma 4a 4b - b 4 - f	mu knowladza			<u> </u>
Gary Ray						

ne ocean Briochte