State W	ell Report						
County Lamar P	art 1						
Mississippi Departmer	t of Environmental Quality and Water Resources Well #: <u>M - 186</u>						
P.O.J	30X 10631						
Jackson, N	1S 39289-0631         L. S. Elevation:           961-5210						
Date drilling completed: 12100 (601)35	4-6938 (fax) E-log #:						
State Law requires that this report be prepared by the	driller in detail and filed with the Department within						
30 days of completion of drilling of the well.							
Well Owner Information	Well Location						
Owner Name D+D Drilling, Inc.	Latitude:°' Longitude:°'						
Mailing Address: P.O. Box 1634	Method of Lat/Long (circle one): Conventional Survey,						
	USGS quad; Hand-held GPS, Survey-grade GPS						
Ferriday, LA 71334 City State Zip Code	<u>1414 Sec_21Twn_1NRng_16 W</u>						
	Distance Direction Nearest Town						
Telephone No. (318) 757 - 3274	Distance Direction of Nearest Town Miles of Nearest Town						
Well	L						
Purpose of Well (circle one) Home Industrial Public Supply	Irrigation Fish Culture Other: Rig Supply						
Date well drilling started: <u>12-2-06</u> Date							
	· · · ·						
If flowing, method of flow regulation: Valve Other (	<b>,</b>						
Static Water Level: 100 feet above of below (circle one)							
Method of Measurement (circle one) steel tape electric tape air line other:							
Hole depth: 261 Well depth: 261	Hole depth: 261 Well depth: 261 Well grouted to a depth of 10 feet						
Type of grout (circle one): Cement Bentonite Mix	-						
Casing length: <u>24</u> feet Casing diameter: <u>4</u>	inches Type of casing: $\underline{PVC}$						
Screen length: <u>20</u> feet Screen diameter: <u>4</u>	inches Type of screen: $PVC$						
	feet tofeet						
Type of completion (circle all applicable). Gravel packed Under	rreamed Telescoped Open hole Natural Development						
Other (describe):							
Top of lap pipe or reduction in casing:feet. If t	elescoped or more than one screen, describe on back of page						
Logs run (circle all applicable: No log run Electric Gamma Ra	y Density Sonic Neutron Other:						
Name of organization running log(s):	accordance with all appliable provisionants of the Mississiumi						
I certify that the well was drilled, constructed, and completed in Department of Environmental Quality and/or the Mississippi De							
RAYEORN DRILLING, INC. 0-60							
Print Name of Water Well Contractor and License No.	Signature of Water Weiton COEIVEL						
	DEC 1 3 2006						
	BY: OLWR						

If well telescopes please sketch below and show depths.

Ground Level

Description of Formations Encountered	From	To
 Red Sandy Clay	0	30
white chalk	30	160
white chalkssand	160	200
Fine Sand	200	335
med Sand	235	240
		<u> </u>
		<u> </u>
		+


M- 186

RECEIVED

DEC 1 3 2006

BY: OLWR

If more than one screen, show location of each on sketch

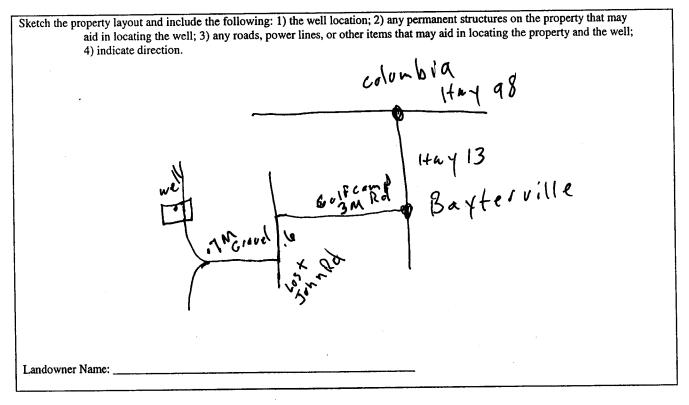

Signature of Water Well Contractor

· · · STATE WE	CLL REPORT
County:     Lamar       Permit #:     Pump Installer's       Driller:     Gary Rayborn       Date completed:     12-2-2006	art 2       For Office Use Only:         completion Report       Aquifer:         t of Environmental Quality       Aquifer:         Most 10631       Well #:
This report should be prepared by the pump installer in detai installation of pump.	
Well Owner Information Dwner Name: D+D Drilling, Inc	Well Location         Latitude:         Longitude:
Mailing Address: P.O. Box 1634	Method of Lat/Long (circle one): Conventional Survey, USGS quad, Hand-held GPS, Survey-grade GPS
<u>Ferriday LA 71334</u> City State Zip Code Telephone No. ( <u>318)</u> 757 - 3274	Distance Direction Nearest Town <u></u>
Pump Type Circle one	Power Type Circle one
Air Lift Jet Submersible	Diesel Engine Gasoline Engine Natural Gas
Bucket Piston Turbine	Electric Motor Hand Tractor PTO
Centrifugal Rotary Flowing Well Other (specifý):	Windmill     Other (specify):       Horse Power Rating of Motor:
Date Pump Installed:	Setting Depth:feet
Rated Pump Capacity: 60 Gallons Per Minute	Number of Stages:
Pump Test Data Date Well Tested: 12-3-06	Method of Measuring Water Level Circle one
Static Water Level (A): <u>100</u> Feet Below Land Surface Pumping Water Level (B):Feet Below Land Surface	Air Line Electric Measuring Line Steel Tape Other (specify):
Drawdown [(B) – (A)]:Feet Below Land Surface	For flowing well, measured shut in head:feet
Fest Pumping Rate: 60 Gallons Per Minute	Well yielded GPM with a drawdown of
Duration of Pump Test (minimum 4 hours):hours	feet afterhours of pumping
I HEREBY CERTIFY that the above statements are true to the best or Gary Rayborn 0-60 Print Name of Pump Installer and License No. (if applicable)	f my knowledge. Signature f Pump Installer RECEIVE

•

	2			J	200	0
				•		
R	V	*	$\cap$	ž	W	$\square$
هيدا	đ	4	5		¥Υ	