

# State Well Report

## Part 1

Mississippi Department of Environmental Quality  
Office of Land and Water Resources  
P.O. Box 10631  
Jackson, MS 39289-0631  
(601)961-5210  
(601)354-6938 (fax)

For Office Use Only:

Aquifer: \_\_\_\_\_  
Well #: M-208  
L. S. Elevation: \_\_\_\_\_  
E-log #: \_\_\_\_\_

County: LAMAR  
Permit #: \_\_\_\_\_  
Driller: GARY RAYBORN  
Date drilling completed: 9-5-2007

State Law requires that this report be prepared by the driller in detail and filed with the Department within 30 days of completion of drilling of the well.

Well Owner Information	Well Location
Owner Name: <u>D+D Drilling Inc</u>	Latitude: _____ Longitude: _____
Mailing Address: <u>P.O. Box 1634</u>	Method of Lat/Long (circle one): Conventional Survey, USGS quad, Hand-held GPS, Survey-grade GPS
<u>Ferriday LA 71334</u> City State Zip Code	_____ 1/4 _____ 1/4 Sec <u>22</u> Twn <u>1N</u> Rng <u>16W</u>
Telephone No. <u>(318) 757-3274</u>	Distance _____ Miles Direction _____ of Nearest Town <u>Baxterville</u>
Well Data	
Purpose of Well (circle one) Home Industrial Public Supply Irrigation Fish Culture <u>Other: Rig Supply</u>	
Date well drilling started: <u>9-4-07</u>	Date well drilling completed: <u>9-5-07</u>
If flowing, method of flow regulation: Valve _____ Other (describe) _____	
Static Water Level: <u>155'</u> feet above <u>or below</u> (circle one) land surface	Date measured: <u>9-5-07</u>
Method of Measurement (circle one) steel tape electric tape <u>air line</u> other: _____	
Hole depth: <u>250'</u> Well depth: <u>250'</u>	Well grouted to a depth of <u>10</u> feet
Type of grout (circle one): <u>Cement</u> Bentonite Mix	
Casing length: <u>230</u> feet Casing diameter: <u>4</u> inches	Type of casing: <u>PVC BY: OLWA</u>
Screen length: <u>20</u> feet Screen diameter: <u>4</u> inches	Type of screen: <u>PVC</u>
Screen slot size: <u>.020</u> inches	Setting depth: From <u>230</u> feet to <u>250</u> feet
Type of completion (circle all applicable): <u>Gravel packed</u> Underreamed Telescoped Open hole Natural Development	
Other (describe): _____	
Top of lap pipe or reduction in casing: _____ feet. If telescoped or more than one screen, describe on back of page	
Logs run (circle all applicable): <u>No log run</u> Electric Gamma Ray Density Sonic Neutron Other: _____	
Name of organization running log(s): _____	
I certify that the well was drilled, constructed, and completed in accordance with all applicable requirements of the Mississippi Department of Environmental Quality and/or the Mississippi Department of Health regulations and state laws.	
<u>Rayborn Drilling Inc 0-60</u> Print Name of Water Well Contractor and License No.	<u>[Signature]</u> Signature of Water Well Contractor

# STATE WELL REPORT

## Part 2

**Pump Installer's Completion Report**  
 Mississippi Department of Environmental Quality  
 Office of Land and Water Resources  
 P.O. Box 10631  
 Jackson, MS 39289-0631  
 (601)961-5210  
 (601)354-6938 (fax)

**For Office Use Only:**

Aquifer: \_\_\_\_\_  
 Well #: M-208  
 Elevation: \_\_\_\_\_

County: Lamar  
 Permit #: \_\_\_\_\_  
 Driller: Gary Rayborn  
 Date completed: 9-5-07

This report should be prepared by the pump installer in detail and filed with the Department within 30 days of the installation of pump.

Well Owner Information	Well Location
Owner Name: <u>D + D Drilling Inc</u>	Latitude: _____ Longitude: _____
Mailing Address: <u>P.O. Box 1634</u>	Method of Lat/Long (circle one): Conventional Survey,
<u>Ferriday LA 71334</u>	USGS quad, Hand-held GPS, Survey-grade GPS
City State Zip Code	_____ 1/4 _____ 1/4 Sec <u>22</u> Twn <u>1N</u> Rng <u>16W</u>
Telephone No. (____) _____	Distance Direction Nearest Town
	_____ Miles _____ of <u>Baxtrville</u>

Pump Type Circle one	Power Type Circle one
Air Lift Jet <input type="radio"/> <u>Submersible</u> <input type="radio"/>	Diesel Engine Gasoline Engine Natural Gas
Bucket Piston <input type="radio"/> Turbine <input type="radio"/>	<u>Electric Motor</u> <input type="radio"/> Hand <input type="radio"/> Tractor PTO
Centrifugal Rotary <input type="radio"/> Flowing Well <input type="radio"/>	Windmill Other (specify): _____
Other (specify): _____	Horse Power Rating of Motor: <u>5</u>
Date Pump Installed: <u>9-5-07</u>	Setting Depth: <u>210</u>
Rated Pump Capacity: <u>40</u> Gallons Per Minute	Number of Stages: <u>14</u>

**RECEIVED**  
 SEP 24 2007  
 BY: OLWR

Pump Test Data	Method of Measuring Water Level Circle one
Date Well Tested: <u>9-5-07</u>	<u>Air Line</u> <input type="radio"/> Electric Measuring Line <input type="radio"/> Steel Tape <input type="radio"/>
Static Water Level (A): <u>155</u> Feet Below Land Surface	Other (specify): _____
Pumping Water Level (B): _____ Feet Below Land Surface	For flowing well, measured shut in head: _____ feet
Drawdown [(B) - (A)]: _____ Feet Below Land Surface	Well yielded <u>40</u> GPM with a drawdown of
Test Pumping Rate: <u>40</u> Gallons Per Minute	_____ feet after _____ hours of pumping
Duration of Pump Test (minimum 4 hours): _____ hours	

I HEREBY CERTIFY that the above statements are true to the best of my knowledge.

Gary Rayborn 0-60 \_\_\_\_\_  
 Print Name of Pump Installer and License No. (if applicable) Signature of Pump Installer

m - 208

If well telescopes please sketch below and show depths.


Ground Level

--

Description of Formations Encountered	From	To
Clay Gravel	0	40
Sand + Red Clay	40	80
Clay	80	230
Fine Sand	230	250


If more than one screen, show location of each on sketch

Sketch the property layout and include the following: 1) the well location; 2) any permanent structures on the property that may aid in locating the well; 3) any roads, power lines, or other items that may aid in locating the property and the well; 4) indicate direction.

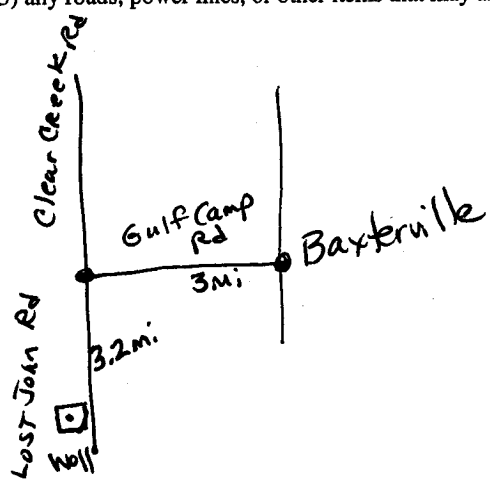

RECEIVED  
 SEP 24 2007  
 BY: OLWR

Landowner Name: \_\_\_\_\_

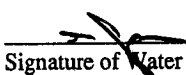 \_\_\_\_\_  
Signature of Water Well Contractor

The first part of the document is a list of names and their corresponding addresses. The names are listed in the left column, and the addresses are listed in the right column. The list is organized in a table-like format with two columns.

The second part of the document is a list of names and their corresponding addresses. The names are listed in the left column, and the addresses are listed in the right column. The list is organized in a table-like format with two columns.

The third part of the document is a list of names and their corresponding addresses. The names are listed in the left column, and the addresses are listed in the right column. The list is organized in a table-like format with two columns.

The fourth part of the document is a list of names and their corresponding addresses. The names are listed in the left column, and the addresses are listed in the right column. The list is organized in a table-like format with two columns.

The fifth part of the document is a list of names and their corresponding addresses. The names are listed in the left column, and the addresses are listed in the right column. The list is organized in a table-like format with two columns.

The sixth part of the document is a list of names and their corresponding addresses. The names are listed in the left column, and the addresses are listed in the right column. The list is organized in a table-like format with two columns.

The seventh part of the document is a list of names and their corresponding addresses. The names are listed in the left column, and the addresses are listed in the right column. The list is organized in a table-like format with two columns.