5.H. Bass # 138 State	Well Report	For Office Use Only:
County: Lamar Mississippi Depart	Part 1 ment of Environmental Quality	Aguifer:
Permit #: Office of La	nd and Water Resources O. Box 10631	Well #: <u>M-222</u>
Driller: Mary Ray Dorn Jackso	on, MS 39289-0631	L. S. Elevation:
	601)961-5210	E-log #:
(00)	1)354-6938 (fax)	
State Law requires that this report be prepared by 30 days of completion of drilling of the well.		
Well Owner Information		I Location
Owner Name_ D&D Drilling, Inc.	Latitude: <u>31 ° C2, 26</u>	2." Longitude: <u>89.39,04</u> ."
Mailing Address: P. O. BOX 1634	Method of Lat/Long (circle o	ne): Conventional Survey,
		d GPS, Survey-grade GPS
Ferriday LA 71334 City State Zip Code	<u>SN 14 SW 14 Sec 18</u>	Twn IN Rng 16W
City State Zip Code Telephone No. (38) 757 - 3274		of <u>Baxteru</u> lle
	Well Data	
	oply Irrigation Fish Culture	
If flowing, method of flow regulation: Valve Ot	ther (describe)	mlalog
Static Water Level: 130 feet above of below circle	$\sim$	:808
Method of Measurement (circle one) steel tape electric		
Hole depth: <u>260'</u> Well depth: <u>260'</u>		feet
Type of grout (circle one): Cement Bentonite Casing length: <u>240</u> feet Casing diameter: <u>4</u>	Mix	PVC
	inches Type of screen:	PNC
0		
	From <u>240</u> feet to	
Type of completion (circle all applicable) Gravel packed		
		•
Top of lap pipe or reduction in casing:fee		
Logs run (circle all applicable). No log run Electric Gamm	na Ray Density Sonic Neutron	Other:
Name of organization running log(s):	ted in accordance with all annlicah	le requirements of the Mississippi
I certify that the well was drilled, constructed, and complete Department of Environmental Quality and/or the Mississip	ppi Department of Health regulatio	ons and state laws.
Department of Environmental Quanty and of the Mississip		Ν.
Rayborn Drilling, Inc 0-6		
Print Name of Water Well Contractor and License No.	Signature	e of Water Well Contractor
		RECEIV
		JUL 18 20

BY: OLWR

	STATE WELL R Part 2	EPORT	Eor Offic	e Use Only:	
County: Lamar	Pump Installer's Complet Mississippi Department of Envir	onmental Quality		- 550 Sung .	
Dormit #	Office of Land and Water Resources P.O. Box 10631			Well #: <u>M-222</u>	
Driller: <u>Gary Rayborn</u> Date completed: <u>7-8-2008</u>	Jackson, MS 39289- (601)961-5210	0631			
	(601)354-6938 (f	•	L		
This report should be prepared by the installation of pump.	pump installer in detail and file	l with the Depar	the second s	of the	
Well Owner Informatio		·	Well Location		
Owner Name: DZDDrillin	G Latitud	e:	Longitude:		
Mailing Address: P.O. Box 16	34 Method	of Lat/Long (circ	cle one): Conventiona	l Survey,	
		•	Hand-held GPS, Surv		
Ferriday LA		1/4 1/4 Se	<u>c 18 Twn IN</u>	$Rng 16 \omega$	
City / State	Zip Code Distance		ion Nearest Toy		
Telephone No. 318 _ 757-3274	4	_Miles SISU	J of Baxten	»'lle	
	l			·····	
Pump Type Circle one			Power Type Circle one		
Air Lift Jet (	Submersible Diesel	Engine G	asoline Engine	Natural Gas	
Bucket Piston	Turbine Electri	Motor I	Hand	Tractor PTO	
Centrifugal Rotary	Flowing Well Windn		Other (specify):		
Other (specify):	Horse	Power Rating of I	Motor: <u>5</u>		
Date Pump Installed:7-8-0			210		
Rated Pump Capacity:	Gallons Per Minute Numb	er of Stages:		<u> </u>	
Pump Test Data		Method	of Measuring Water Circle one	Level	
Date Well Tested:7-8-08	Air Li	na Flant	ic Measuring Line	Steel Tape	
Static Water Level (A):Feet	Below Land Surface			-	
Pumping Water Level (B):Feet	Other	(speciry):	······································	<u> </u>	
Drawdown [(B) – (A)]:Feet		owing well, meas	ured shut in head:	feet	
Test Pumping Rate: (00		yielded	O O GPM with a	drawdown of	
Duration of Pump Test (minimum 4 hours):	-		after		
Duration of Fump Test (minimum 4 nours):					
	wants are true to the best of my br	owledge			
I HEREBY CERTIFY that the above stater $C_{0,0,0,1}$ $P_{0,1}$ $P_{0,1}$ $P_{0,1}$ $P_{0,1}$	nents are true to the best of my kind $(1 - \sqrt{2})$	owieuge.	~~~		
Print Name of Purio Installer and License	No. (if applicable)	Signature of F	Pump Installer		
<u> </u>				RECEIV	
				JUL 182(	

.

BY: OLWR


M-222

If well telescopes please sketch below and show depths.

Ground Level

	Description of Formations Encountered	From	To
<u></u>	CHALK	0	60
	SAND STREAKS	60	100
	CHALK	100	180
	FINE SAND	180	220
	Medium SAND	220	260
			<u> </u>
			+

If more than one screen, show location of each on sketch

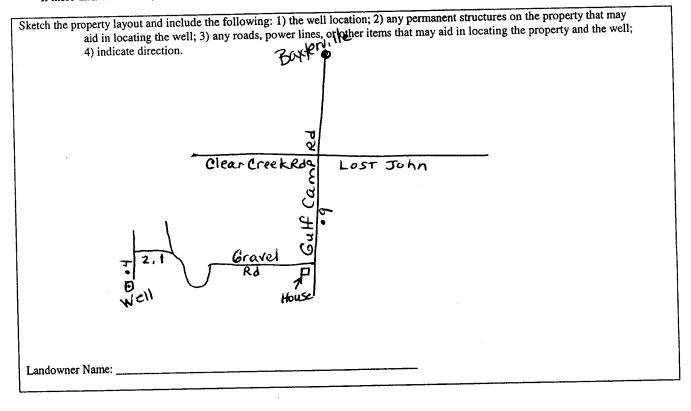

Signature of Water Well Contractor

JUL 18 2008 BY: OLWR