Rig3		
Rig 3 JM Andrews # 108		
	State Well Report Part 1	For Office Use Only:
County: Lamar Mississ	sippi Department of Environmental Qu	ality Aquifer:
Permit #:	Office of Land and Water Resources	Well #:
Driller: Gary Rayborn	P.O. Box 10631 Jackson, MS 39289-0631	L. S. Elevation:
Date drilling completed: 7/27/08	(601)961-5210	
	(601)354-6938 (fax)	E-log #:
State Law requires that this report be p	prepared by the driller in detail and well.	filed with the Department within
30 days of completion of drilling of the Well Owner Information		Well Location
Owner Name D+D Drilling,	Inc. Latitude: 31 ° 04	. , <u>54</u> " Longitude: <u>89 • 38</u> , <u>31</u> "
Mailing Address: P. O. Box 1634	Method of Lat/Long ((circle one): Conventional Survey,
	USGS quad, Ha	and-held GPS, Survey-grade GPS
Ferriday, LA 7 City State	1334 NW 14 NE 14 Se	ec_{fwn} <u>IN_{Rng}</u> <u>IbW</u>
City State Telephone No. (3η) 757- 3274	Zip Code Distance Dir Miles	Sw of Baxterville
	Well Data	
	Wen Data	Ria Supply
Purpose of Well (circle one) Home Industrial	Public Supply Irrigation Fish C	alture Other: Hig suff.g
Date well drilling started: 7-26-08	Date well drilling completed	ulture Other: Rig Supply
If flowing method of flow regulation: Valve	Other (describe)	
Static Water Level:feet above or	below (circle one) land surface Date m	easured: 7-27-08
Method of Measurement (circle one) steel tape	and the second sec	er:
Hole depth: <u>240</u> Well depth:	240 Well grouted to a d	lepth offeet
Type of grout (circle one): Cement Bent	1	casing: PVC
Casing length: 220 feet Casing diam	neter: <u> </u>	
Screen length: <u>20</u> feet Screen diam	meter: inches Type of	screen: <u>PVC</u>
	tting depth: From <u>220</u> feet	to 240 feet
Type of completion (circle all applicable): Grav	vel packed Underreamed Telescoped	d Open hole Natural Development
Top of lap pipe or reduction in casing:		n one screen, describe on back of page
Logs run (circle all applicable): No log run Ele		
Name of organization running log(s): I certify that the well was drilled, constructed,	and completed in accordance with all a	pplicable requirements of the Mississippi
Department of Environmental Quality and/or	the Mississippi Department of Health re	egulations and state laws.
RAYBORN DRILLING, INC.	0-60	7-8-
Print Name of Water Well Contractor and Licens	se No.	ignature of Water Well Contractor
	RECEIVE	D RECEIVED
	AUG 18 200	AUG 1 1 2008
	BY: OLW	WATER RESOURCES PROGRALA DEPT. OF TRANS. & DEV

		LL REPORT			
County: Lamar	Part 2 Pump Installer's Completion Report Mississippi Department of Environmental Quality		For Office Use Only: Aquifer:		
Permit #: Driller: <u>Gary Rayborn</u> Date completed:7-27-08	P.O. E Jackson, M (601)	nd Water Resources Box 10631 IS 39289-0631 961-5210	Well #: <u>M-224</u> Elevation:		
This report should be prepared by th		4-6938 (fax) l and filed with the Departme			
installation of pump. Well Owner Informa			Il Location		
Owner Name: D& D Drilling, Inc.		Latitude:	Latitude:Longitude:		
Mailing Address:		Method of Lat/Long (circle o	ne): Conventional Survey,		
P.O. Box 1634 Ferriday, LA 71334		USGS quad, Hand-held GPS, Survey-grade GPS			
City State Zip Code		Distance Direction Nearest Town			
Telephone No. (313) 757 - 32*	14	$\underline{3}_{\text{Miles}} \underline{\omega}_{\text{SW}}$	of Baxter, le		
Pump Type Circle one	<u></u>		ower Type Circle one		
Air Lift Jet 🕻	Submersible	Diesel Engine Gasol	ine Engine Natural Gas		
Bucket Piston	Turbine (Electric Motor Hand	Tractor PTO		
Centrifugal Rotary	Flowing Well		(specify):		
Other (specify):	<u> </u>	Horse Power Rating of Moto			
Date Pump Installed: <u>7-27-</u>		Setting Depth:	<i>·</i> •		
Rated Pump Capacity:	_Gallons Per Minute	Number of Stages:	<u> </u>		
Pump Test Data			leasuring Water Level Circle one		
Date Well Tested: <u>1-27.0</u>	8		easuring Line Steel Tape		
Static Water Level (A):Feet Below Land Surface		Other (specify):			
Pumping Water Level (B):Fee	t Below Land Surface	Outer (speens):			
Drawdown [(B) – (A)]:Fee	et Below Land Surface	-	shut in head:feet		
Test Pumping Rate:	Gallons Per Minute	Well yielded	GPM with a drawdown of		
1est Pumping Rate:					

Print Name of Pump Installer and License No. (if applicable)

· ·

.

Signature of Pump Installer

AUG 18 2008


M-224

If well telescopes please sketch below and show depths.



Description of Formations Encountered	From	To
 White Clay	0	180
		200
Fine Sand		
Fine Sand Medium Sand	200	240
		+
		-
		_

If more than one screen, show location of each on sketch

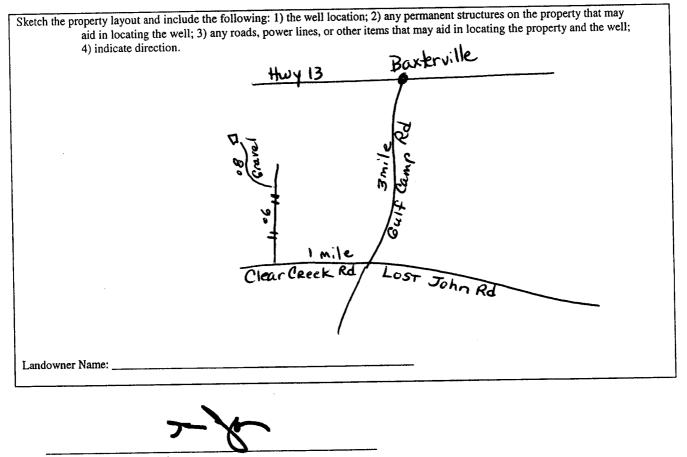

Signature of Water Well Contractor

AUG 18 2008 BY: OLWR