	State W	ell Report		
- 1000010		art 1	For Office Use Only:	
County: Lamar	Mississippi Departmen	Aquifer:		
Permit #:		and Water Resources	Well #: $M - 232$	
Driller: Gary Rayborn		30x 10631 4S 39289-0631	L. S. Elevation:	
Date drilling completed: 10 16 08	Jackson, MS 39289-0631 (601)961-5210 (601)354-6938 (fax)			
Date drining completed.			E-log #:	
State Law requires that this rep	ort be prepared by the	driller in detail and filed w	ith the Department within	
30 days of completion of drilling of the well. Well Owner Information		Well Location		
Owner Name Tellus Operating Group Mailing Address: 4 Gulf Camp Rivele		Latitude: 31 ° 02 '25 " Longitude: 49 ° 38 ,57		
		Method of Lat/Long (circle one): Conventional Survey,		
		USGS quad; Hand-held GPS, Survey-grade GPS		
Lumberton MS 39455 City State Zip Code		SE 14 SW 14 Sec 18 Twn IN Rng 164		
		Distance Direction Nearest Town 5 Miles 5/5w of Bax Crulle		
Telephone No. (<u>60)</u> 796 - 42	45	<u>5</u> Miles <u>5/5</u> W	of Baxterville	
	Well	Data		
Purpose of Well (circle one) Home Inc		Irrigation Fish Culture	\bigcirc , \cdots	
			•	
If flowing, method of flow regulation: Va				
If flowing, method of flow regulation: Va Static Water Level: 135' feet a				
Static Water Level: 135 feet a		land surface Date measured:		
Static Water Level: 135 feet a	bove of below (circle one) teel tape electric tape	land surface Date measured:		
Static Water Level: 135' feet al Method of Measurement (circle one) s	teel tape electric tape epth: 280	land surface Date measured: e air line other: Well grouted to a depth of	10 feet	
Static Water Level: 135 feet al Method of Measurement (circle one) s Hole depth: 280 Well de Type of grout (circle one): Cement Casing length: 260 feet Casi	teel tape electric tape epth: 280' Bentonite Mix ing diameter: 4	land surface Date measured: air line other: Well grouted to a depth of inches Type of casing:	10 feet	
Static Water Level:135	teel tape electric tape epth: 280' Bentonite Mix ing diameter: 4 een diameter: 4	land surface Date measured: e air line other: Well grouted to a depth of inches Type of casing: inches Type of screen:	10 feet PVC PVC	
Static Water Level: 135 feet al Method of Measurement (circle one) s Hole depth: 280 Well de Type of grout (circle one): Cement Casing length: 260 feet Casi Screen length: 20 feet Screen Screen slot size: 620 inches	bove of below (circle one) teel tape electric tape tepth: 280' Bentonite Mix ing diameter: 4 cen diameter: 4 Setting depth: From	land surface Date measured: air line other: Well grouted to a depth of inches Type of casing: inches Type of screen: 260 feet to	10 feet PVC PVC 280 feet	
Static Water Level:135	bove of below (circle one) teel tape electric tape tepth: 280' Bentonite Mix ing diameter: 4 cen diameter: 4 Setting depth: From	land surface Date measured: air line other: Well grouted to a depth of inches Type of casing: inches Type of screen: 260 feet to	10 feet PVC PVC	
Static Water Level: 135 feet al Method of Measurement (circle one) s Hole depth: 280 Well de Type of grout (circle one): Cement Casing length: 260 feet Casi Screen length: 20 feet Screen Screen slot size: 620 inches	bove of below (circle one) teel tape electric tape ppth: 280' Bentonite Mix ing diameter: 4 een diameter: 4 Setting depth: From Gravel packed Under	land surface Date measured: air line other: Well grouted to a depth of inches Type of casing: inches Type of screen: 260 feet to	PVC PVC 280 feet hole Natural Development	
Static Water Level: 135 feet al Method of Measurement (circle one) s Hole depth: 280 Well de Type of grout (circle one): Cement Casing length: 260 feet Casi Screen length: 20 feet Screen Screen slot size: 620 inches	bove of below (circle one) teel tape electric tape ppth: 280 Bentonite Mix ing diameter: 4 een diameter: 4 Setting depth: From Gravel packed Under Other (describe): 4	land surface Date measured: air line other: Well grouted to a depth of inches Type of casing: inches Type of screen: 260 feet to erreamed Telescoped Oper	PVC PVC 280 feet hole Natural Development reen, describe on back of page	

Department of Environmental Quality and/or the Mississippi Department of Health regulations and state laws.

Print Name of Water Well Contractor and License No.

RECEIVED

Signature of Water Well Contractor

NOV 07 2008

BY: OLWR

STATE WELL REPORT

Part 2

Pump Installer's Completion Report
Mississippi Department of Environmental Quality

Lamar

Print Name of Pump Installer and License No. (if applicable)

County: _

Permit #:

Driller: 60

Office of Land and Water Resources
P.O. Box 10631
Jackson, MS 39289-0631
(601)961-5210

For Office Use Only:				
Aquifer:				
Well #: M-232				
Elevation:				

Date completed: 101608		4-6938 (fax)	Elevation:		
This report should be prepared by th installation of pump.		il and filed with the De	epartment within 30 day	ys of the	
Well Owner Information		Well Location			
Owner Name: Tellus Operating Grp		Latitude:Longitude:			
Mailing Address: 4 Gulf Can	p Rd	Method of Lat/Long	(circle one): Convention	al Survey,	
		USGS qua	ad, Hand-held GPS, Sur	rvey-grade GPS	
Lumberton, US 39456 City State Zip Code		1414 Sec18 Twn_1N Rng 16 W			
City State	Zip Code	Distance Dir	rection Nearest To	own	
Telephone No. (601) 796-424	13	5_Miles S	sw of Baxte	rville	
Pump Type Circle one			Power Type Circle one		
Air Lift Jet	Submersible	Diesel Engine	Gasoline Engine	Natural Gas	
Bucket Piston	Turbine (Electric Motor	Hand	Tractor PTO	
Centrifugal Rotary	Flowing Well	Windmill	Other (specify):		
Other (specify):		Horse Power Rating	of Motor: 5 HF	2	
Date Pump Installed: 10/16/2008		Setting Depth: 168 feet			
Rated Pump Capacity:	_Gallons Per Minute	Number of Stages: _	Ш		
Pump Test Data		Meth	od of Measuring Water	Level	
-	. 0		Circle one		
Date Well Tested: 10-16-0		Air Line Ele	ectric Measuring Line	Steel Tape	
Static Water Level (A): 135 Fee	t Below Land Surface	Other (specify):			
Pumping Water Level (B):Feet	Below Land Surface	Januar (179993),/			
Drawdown [(B) – (A)]:Fee	t Below Land Surface	For flowing well, me	easured shut in head:	feet	
Test Pumping Rate:	_Gallons Per Minute	Well yielded	GPM with a	drawdown of	
Duration of Pump Test (minimum 4 hours)	:hours	fo	eet after	hours of pumping	
I HEREBY CERTIFY that the above state		of my knowledge.			
Gazy Rayborn	0-60				

Signature of Pump installer

RECEIVED


NOV 07 2008

BY: OLWR

Ground Level

Description of Formations Encountered	From	То
Red Sandy Clay	O	80
white chalk wisend strks	80	150
White Chalk	150	225
Fine Sand	225	240
Medium Sand	240	260
Coarse Sand	260	280
	1	

If more than one screen, show location of each on sketch

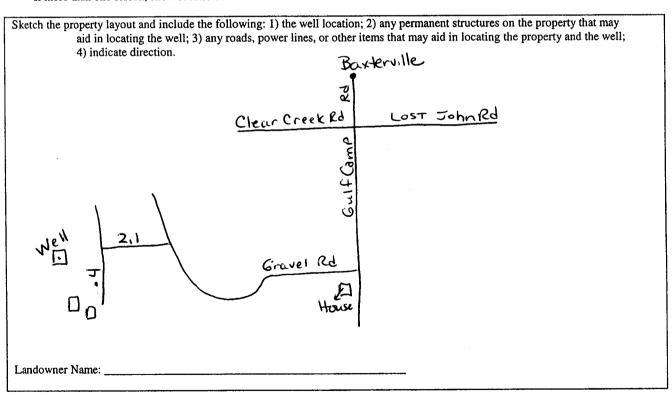

Signature of Water Well Contractor

RECEIVED

NOV 07 2008

BY: OLWR