Weyerhauser 15-9 # 282 H	Well Deport
County: Lamar	Well Report For Office Use Only: Part 1 Aquifer:
Permit #: Office of Land	d and Water Resources $M - 233$
	b. Box 10631 , MS 39289-0631 L. S. Elevation:
Date drilling completed: 10124108 (60	01)961-5210
(601)	354-6938 (fax)
State Law requires that this report be prepared by t 30 days of completion of drilling of the well.	he driller in detail and filed with the Department within
Well Owner Information	Well Location
Owner Name Penn-Va OII 3 Gas	Latitude: 31 <u>• 02 · 42</u> " Longitude: <u>89 • 35 · 15</u> "
Mailing Address: 2550 East Stone Dr	Method of Lat/Long (circle one): Conventional Survey,
Suite 110	USGS quad, Hand-held GPS, Survey-grade GPS
Kingsport, TN 37760	NE 14 SE 14 Sec 15 TWN IN Rng 16W
$\frac{1}{City} \qquad \qquad$	Distance Direction Nearest Town <u>4,5 Miles</u> of <u>Bayterulle</u>
We	ell Data
	y Irrigation Fish Culture Other: Rig Supply
Date well drilling started: 10/24/08 Da	ate well drilling completed:
If flowing, method of flow regulation: Valve Othe	
Static Water Level:feet above or below circle or	ne) land surface Date measured: 10/24/08
Method of Measurement (circle one) steel tape electric t	ape air line other:
Hole depth: 200 Well depth: 200	Well grouted to a depth offeet
r)pe or grout (enter one).	fix
Casing length: <u>180</u> feet Casing diameter: <u>4</u>	inches Type of casing: ρ_{VC}
Screen length: <u>20</u> feet Screen diameter: <u>4</u>	inches Type of screen:PUC
Screen slot size: <u>020</u> inches Setting depth: Fro	m 180 feet to 200 feet
Type of completion (circle all applicable) Gravel packed Ur	nderreamed Telescoped Open hole Natural Development
Other (describe):	
	If telescoped or more than one screen, describe on back of page
Logs run (circle all applicable) No log run Electric Gamma l	Ray Density Sonic Neutron Other:
Name of organization running log(s):	
I certify that the well was drilled, constructed, and completed Department of Environmental Quality and/or the Mississippi	in accordance with all applicable requirements of the Mississippi Department of Health regulations and state laws.
RAYBORN DRILLING, INC. $O-(\phi)$	
Print Name of Water Well Contractor and License No.	Signature of Water Wen Contractor
	RECEIVE
	NOV 07 2008
	BY: OLWF

.

٢

Part 2 's Completion Report int of Environmental Quality and Water Resources Box 10631 MS 39289-0631 1)961-5210 54-6938 (fax) ail and filed with the Department within 30 days of the Well Location Latitude: Longitude: Method of Lat/Long (circle one): Conventional Survey,
Well Location Latitude: Longitude:
Latitude:Longitude:
USGS quad, Hand-held GPS, Survey-grade GPS <u>14</u> <u>14 Sec 15</u> Twn <u>1N</u> Rng <u>16</u> <u>16</u> Distance Direction Nearest Town <u>4.5</u> Miles <u>5E</u> of <u>Baxterville</u>
Power Type Circle one
Diesel Engine Gasoline Engine Natural Ga
Electric Motor Hand Tractor PT
Windmill Other (specify):
Horse Power Rating of Motor: <u>5 HP</u> Setting Depth: <u>168</u> feet
Number of Stages:/
Method of Measuring Water Level
Circle one Air Line Electric Measuring Line Steel Tape Other (specify):
For flowing well, measured shut in head:fee
Well yielded GPM with a drawdown of
feet afterhours of pumping

NOV 07 2008

BY: OLWR


•

If well telescopes please sketch below and show depths.

Ground Level

Level	Description of Formations Encountered	From	To
	Red Clay Gravel	0	60
	Red Sand + Clay	60	120
	White Chalk	120	140
	Fine Sand	140	160
	Medium SAND	160	200

If more than one screen, show location of each on sketch

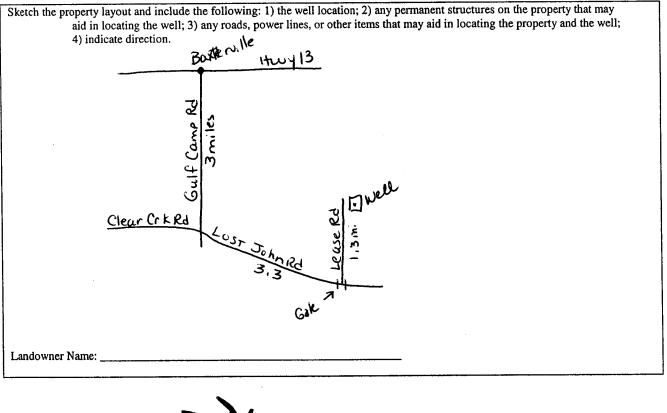

Signature of Water Well Contractor

M - 233 From To

NOV 07 2008 BY: OLWR