

1st of 2 water wells on Location  
Weyerhaeuser 29-6-387H

### State Well Report

Part 1

Mississippi Department of Environmental Quality  
Office of Land and Water Resources  
P.O. Box 10631  
Jackson, MS 39289-0631  
(601)961-5210  
(601)354-6938 (fax)

For Office Use Only:

Aquifer: \_\_\_\_\_  
Well #: M-242  
L. S. Elevation: \_\_\_\_\_  
E-log #: \_\_\_\_\_

County: Lamar  
Permit #: \_\_\_\_\_  
Driller: Gary Rayborn  
Date drilling completed: 1-21-09

State Law requires that this report be prepared by the driller in detail and filed with the Department within 30 days of completion of drilling of the well.

Well Owner Information	Well Location
Owner Name: <u>Penn-Va Oil &amp; Gas</u>	Latitude: <u>31° 01' 06"</u> Longitude: <u>89° 37' 56"</u>
Mailing Address: <u>Suite 110</u> <u>2550 E. Stone Dr</u> <u>Kingsport TN 37760</u> City State Zip Code	Method of Lat/Long (circle one): Conventional Survey, USGS quad, Hand-held GPS, Survey-grade GPS <u>SE</u> ¼ <u>NW</u> ¼ Sec <u>29</u> Twn <u>1N</u> Rng <u>16W</u>
Telephone No. ( <u>601</u> ) <u>731-4333</u>	Distance <u>4</u> Miles Direction <u>S</u> of Nearest Town <u>Baxterville</u>

**Well Data**

Purpose of Well (circle one) Home Industrial Public Supply Irrigation Fish Culture Other: Rig Supply

Date well drilling started: 1-20-2009 Date well drilling completed: 1-21-2009

If flowing, method of flow regulation: Valve \_\_\_\_\_ Other (describe) \_\_\_\_\_

Static Water Level: 145 feet above or below (circle one) land surface Date measured: 1-21-2009

Method of Measurement (circle one) steel tape electric tape air line other: \_\_\_\_\_

Hole depth: 270' Well depth: 270' Well grouted to a depth of 10 feet

Type of grout (circle one): Cement Bentonite Mix

Casing length: 230 feet Casing diameter: 4" inches Type of casing: PVC

Screen length: 40 feet Screen diameter: 4" inches Type of screen: PVC

Screen slot size: .020 inches Setting depth: From 230 feet to 270 feet

Type of completion (circle all applicable): Gravel packed Underreamed Telescoped Open hole Natural Development

Other (describe): \_\_\_\_\_

Top of lap pipe or reduction in casing: \_\_\_\_\_ feet. If telescoped or more than one screen, describe on back of page

Logs run (circle all applicable): No log run Electric Gamma Ray Density Sonic Neutron Other: \_\_\_\_\_

Name of organization running log(s): \_\_\_\_\_

I certify that the well was drilled, constructed, and completed in accordance with all applicable requirements of the Mississippi Department of Environmental Quality and/or the Mississippi Department of Health regulations and state laws.

RAYBORN DRILLING, INC. 0-60 \_\_\_\_\_  
Print Name of Water Well Contractor and License No. Signature of Water Well Contractor

RECEIVED  
FEB 05 2009  
BY: OLWR



# STATE WELL REPORT

## Part 2

**Pump Installer's Completion Report**  
 Mississippi Department of Environmental Quality  
 Office of Land and Water Resources  
 P.O. Box 10631  
 Jackson, MS 39289-0631  
 (601)961-5210  
 (601)354-6938 (fax)

For Office Use Only:

Aquifer: \_\_\_\_\_  
 Well #: M-242  
 Elevation: \_\_\_\_\_

County: Lamar  
 Permit #: \_\_\_\_\_  
 Driller: Gary Rayborn  
 Date completed: 1-21-09

**This report should be prepared by the pump installer in detail and filed with the Department within 30 days of the installation of pump.**

Well Owner Information	Well Location
Owner Name: <u>Penn-Va Oil &amp; Gas</u>	Latitude: _____ Longitude: _____
Mailing Address: <u>Suite 110</u>	Method of Lat/Long (circle one): Conventional Survey,
<u>2550 E. Stone Dr</u>	USGS quad, Hand-held GPS, Survey-grade GPS
<u>Kingsport TN 37760</u>	_____ ¼ _____ ¼ Sec <u>29</u> Twn <u>1N</u> Rng <u>16W</u>
City State Zip Code	Distance Direction Nearest Town
Telephone No. ( <u>601</u> ) <u>731-4333</u>	<u>4</u> Miles <u>S</u> of <u>Baxterville</u>

Pump Type Circle one	Power Type Circle one
Air Lift Jet <input checked="" type="checkbox"/> <b>Submersible</b>	Diesel Engine Gasoline Engine Natural Gas
Bucket Piston Turbine	<input checked="" type="checkbox"/> <b>Electric Motor</b> Hand Tractor PTO
Centrifugal Rotary Flowing Well	Windmill Other (specify): _____
Other (specify): _____	Horse Power Rating of Motor: <u>5HP</u>
Date Pump Installed: <u>1-21-09</u>	Setting Depth: <u>210</u> feet
Rated Pump Capacity: <u>60</u> Gallons Per Minute	Number of Stages: <u>11</u>

Pump Test Data	Method of Measuring Water Level Circle one
Date Well Tested: _____	Air Line <input checked="" type="checkbox"/> <b>Electric Measuring Line</b> Steel Tape
Static Water Level (A): <u>145</u> Feet Below Land Surface	Other (specify): _____
Pumping Water Level (B): _____ Feet Below Land Surface	For flowing well, measured shut in head: _____ feet
Drawdown [(B) - (A)]: _____ Feet Below Land Surface	Well yielded <u>60</u> GPM with a drawdown of
Test Pumping Rate: <u>60</u> Gallons Per Minute	_____ feet after _____ hours of pumping
Duration of Pump Test (minimum 4 hours): _____ hours	

I HEREBY CERTIFY that the above statements are true to the best of my knowledge.


GARY RAYBORN 0-60 \_\_\_\_\_  
 Print Name of Pump Installer and License No. (if applicable) Signature of Pump Installer

RECEIVED  
 FEB 05 2009  
 BY: OLWR

M-242

If well telescopes please sketch below and show depths.


Ground Level

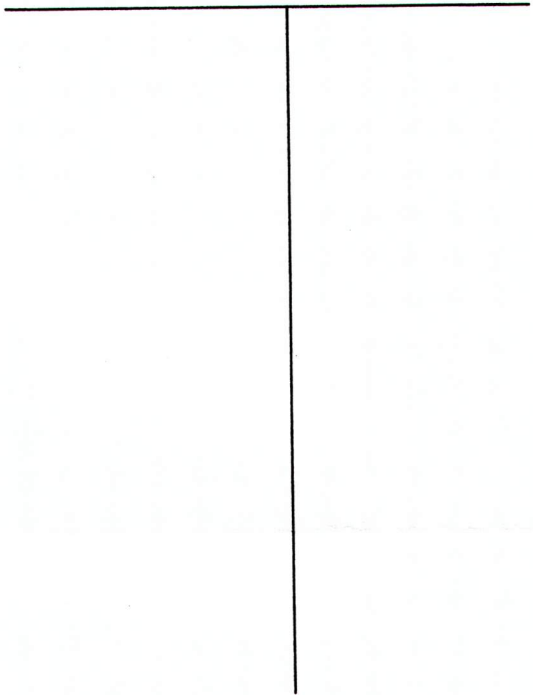

Description of Formations Encountered	From	To
Red SANDY CLAY	0	40
WHITE CHALK	40	230
MEDIUM SAND	230	270

If more than one screen, show location of each on sketch

Sketch the property layout and include the following: 1) the well location; 2) any permanent structures on the property that may aid in locating the well; 3) any roads, power lines, or other items that may aid in locating the property and the well; 4) indicate direction.

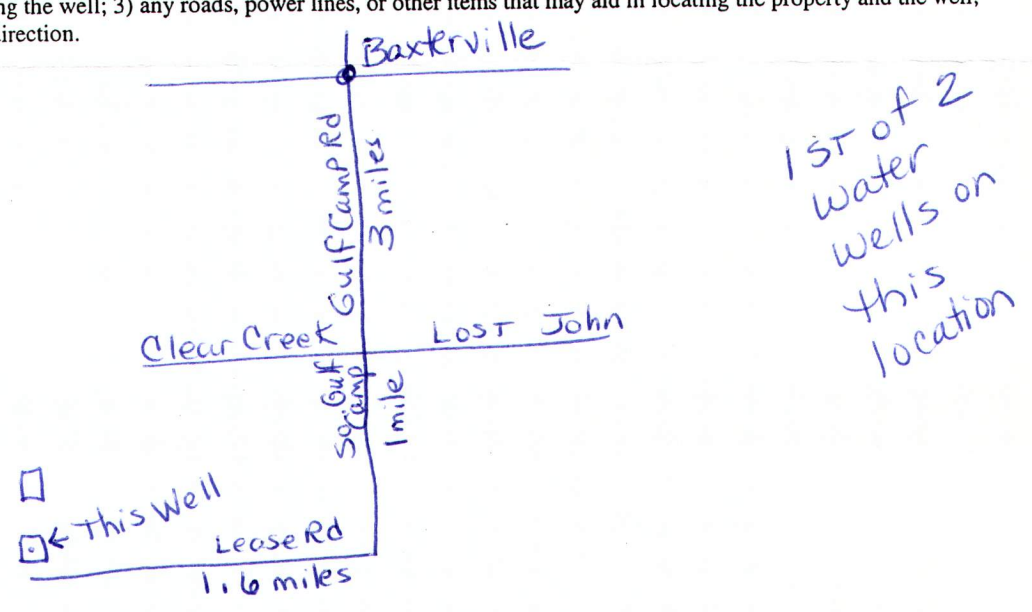

Landowner Name: \_\_\_\_\_

*[Handwritten Signature]*

Signature of Water Well Contractor

**RECEIVED**  
**FEB 0 5 2009**  
**BY: OLWR**