

I.H. Bass 163-H

State Well Report

Part 1

Mississippi Department of Environmental Quality
Office of Land and Water Resources
P.O. Box 10631
Jackson, MS 39289-0631
(601)961-5210
(601)354-6938 (fax)

County: Lamar
 Permit #: _____
 Driller: Gary Rayborn
 Date drilling completed: 4-26-10

For Office Use Only:
 Aquifer: M 253
 Well #: _____
 L. S. Elevation: _____
 E-log #: _____

State Law requires that this report be prepared by the driller in detail and filed with the Department within 30 days of completion of drilling of the well.

Well Owner Information	Well Location
Owner Name: <u>Jellus Operating</u>	Latitude: <u>31.04.01</u> Longitude: <u>89.36.22</u>
Mailing Address: <u>602 Crescent Pl</u>	Method of Lat/Long (circle one): <u>Conventional Survey</u>
<u>Suite 100</u>	USGS quad, Hand-held GPS, Survey-grade GPS
<u>Ridgeland MS 39151</u>	<u>NE 1/4 NE 1/4 Sec 9 Twn 1 N Rng 16 W</u>
City State Zip Code	Distance Direction Nearest Town
Telephone No. <u>(601)382-4923</u>	<u>1.5</u> Miles <u>S</u> of <u>Baxterville</u>

Well Data

Purpose of Well (circle one) Home Industrial Public Supply Irrigation Fish Culture Other: Rig Supply

Date well drilling started: 4-26-10 Date well drilling completed: 4-26-10

If flowing, method of flow regulation: Valve _____ Other (describe) _____

Static Water Level: 55' feet above or below (circle one) land surface Date measured: 4-26-10

Method of Measurement (circle one) steel tape electric tape air line other: _____

Hole depth: 135' Well depth: 135' Well grouted to a depth of 10 feet

Type of grout (circle one): Cement Bentonite Mix

Casing length: 115 feet Casing diameter: 4 inches Type of casing: PVC

Screen length: 20 feet Screen diameter: 4 inches Type of screen: PVC

Screen slot size: .020 inches Setting depth: From 115 feet to 135 feet

Type of completion (circle all applicable): Gravel packed Underreamed Telescoped Open hole Natural Development

Other (describe): _____

Top of lap pipe or reduction in casing: _____ feet. If telescoped or more than one screen, describe on back of page

Logs run (circle all applicable): No log run Electric Gamma Ray Density Sonic Neutron Other: _____

Name of organization running log(s): _____

I certify that the well was drilled, constructed, and completed in accordance with all applicable requirements of the Mississippi Department of Environmental Quality and/or the Mississippi Department of Health regulations and state laws.

Rayborn Drilling, Inc. 0-60
Print Name of Water Well Contractor and License No.

[Signature]
Signature of Water Well Contractor

RECEIVED
MAY 14 2010
BY: OLWR

STATE OF TEXAS
COUNTY OF _____
I, _____
do hereby certify that _____
is the true and correct _____

STATE WELL REPORT

Part 2

Pump Installer's Completion Report
 Mississippi Department of Environmental Quality
 Office of Land and Water Resources
 P.O. Box 10631
 Jackson, MS 39289-0631
 (601)961-5210
 (601)354-6938 (fax)

County: Lamar
 Permit #: _____
 Driller: Gary Rayborn
 Date completed: 4-26-10

For Office Use Only:

Aquifer: M 253
 Well #: _____
 Elevation: _____

This report should be prepared by the pump installer in detail and filed with the Department within 30 days of the installation of pump.

Well Owner Information	Well Location
Owner Name: <u>Tellus Operating</u>	Latitude: _____ Longitude: _____
Mailing Address: <u>602 Crescent Place</u>	Method of Lat/Long (circle one): Conventional Survey,
<u>Suite 100</u>	USGS quad, Hand-held GPS, Survey-grade GPS
<u>Ridgeland, MS 39157</u>	_____ ¼ _____ ¼ Sec <u>9</u> Twn <u>1N</u> Rng <u>16W</u>
City State Zip Code	Distance Direction Nearest Town
Telephone No. <u>(601) 382-4923</u>	<u>1.5</u> Miles <u>S</u> of <u>Baxterville</u>

Pump Type Circle one	Power Type Circle one
Air Lift Jet <input type="radio"/> Submersible <input checked="" type="radio"/>	Diesel Engine Gasoline Engine Natural Gas
Bucket Piston <input type="radio"/> Turbine <input type="radio"/>	Electric Motor <input checked="" type="radio"/> Hand Tractor PTO
Centrifugal Rotary <input type="radio"/> Flowing Well <input type="radio"/>	Windmill Other (specify): _____
Other (specify): _____	Horse Power Rating of Motor: <u>5HP</u>
Date Pump Installed: <u>4-26-10</u>	Setting Depth: <u>105</u> feet
Rated Pump Capacity: <u>60</u> Gallons Per Minute	Number of Stages: <u>11</u>

Pump Test Data	Method of Measuring Water Level Circle one
Date Well Tested: <u>4-26-10</u>	Air Line <input type="radio"/> Electric Measuring Line <input checked="" type="radio"/> Steel Tape
Static Water Level (A): <u>55</u> Feet Below Land Surface	Other (specify): _____
Pumping Water Level (B): _____ Feet Below Land Surface	For flowing well, measured shut in head: _____ feet
Drawdown [(B) - (A)]: <u>0</u> Feet Below Land Surface	Well yielded <u>60</u> GPM with a drawdown of
Test Pumping Rate: <u>60</u> Gallons Per Minute	_____ feet after _____ hours of pumping
Duration of Pump Test (minimum 4 hours): _____ hours	

I HEREBY CERTIFY that the above statements are true to the best of my knowledge.

Gary Rayborn 0-60
 Print Name of Pump Installer and License No. (if applicable)

RECEIVED
 MAY 14 2010
 BY: OLWF

RECEIVED
 MAY 14 2010
 BY: OLWF

M 253

If well telescopes please sketch below and show depths.


Ground Level

--	--

Description of Formations Encountered	From	To
Red Clay	0	40
Red Sand w/ clay streaks	40	80
Coarse Sand	80	135

If more than one screen, show location of each on sketch

Sketch the property layout and include the following: 1) the well location; 2) any permanent structures on the property that may aid in locating the well; 3) any roads, power lines, or other items that may aid in locating the property and the well; 4) indicate direction.

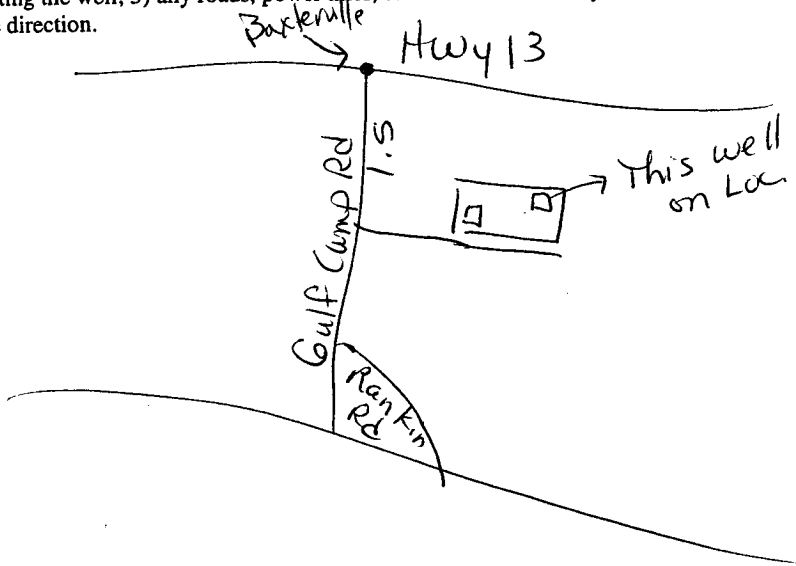

Landowner Name: _____



 Signature of Water Well Contractor

RECEIVED
 MAY 14 2010
 BY: OLWR