		Moul	hauser 23-4-4281t
			Well 2 of 3
		ell Report art 1	For Office Use Only:
County: Lamar	Mississippi Department	of Environmental Quality	Aquifer: M_{257}
Permit #:	Office of Land a	nd Water Resources	Well #:
Driller: Gary Rayborn	Jackson, M	S 39289-0631 961-5210	L. S. Elevation:
Date drilling completed: <u>9-16-10</u>		4-6938 (fax)	E-log #:
State Law requires that this rep	oort be prepared by the	driller in detail and filed v	with the Department within
30 days of completion of drilling Well Owner Inform	g of the well.	We	ll Location
Owner Name Renn-Va Oi	1 Gas Corp	Latitude: 31 . 02 . 16	Longitude: <u>89.35</u> (7
Mailing Address: 840 Gessn	er Suite 800	Method of Lat/Long (circle of	
DEPT AP	-300		ld GPS, Survey-grade GPS
	X 77024	NW 1/ NYLAS Sec_2	<u>3 Twn IN Rng 16 W</u>
City s Telephone No. <u>423</u> 723 -	tate Zip Code O 2 8	Distance Direction	of <u>Baxteru</u> , lle
		Data	OA
Purpose of Well (circle one) Home In Date well drilling started: $9 - 16$	ndustrial Public Supply	Irrigation Fish Culture well drilling completed:	
If flowing, method of flow regulation:	Valve Other (describe)	
Static Water Level: <u>140</u> feet	above on below (circle one)	land surface Date measured	d: <u>9-16-10</u>
Method of Measurement (circle one)	steel tape electric tap		10
Hole depth: <u>260</u> Well	•	Well grouted to a depth o	ffeet
Type of grout (circle one): Cement)	Bentonite Mix	xinches Type of casing	PVC
Casing longui.	asing diameter:	inches Type of screen	DUC
	creen diameter: <u>7</u>	2110	260 feet
Screen slot size: 020 inche			
Type of completion (circle all applicabl			pen hole Natural Development
	Other (describe):		
Top of lap pipe or reduction in casing:			screen, describe on back of page
Logs run (circle all applicable): No log			•
Name of organization running log(s): _ I certify that the well was drilled, con	nstructed, and completed i	n accordance with all applica	ble requirements of the Mississippi
I certify that the well was in med, con Department of Environmental Quali	ty and/or the Mississippi I	Department of Health regulation	ions and state laws.
AVCORN DRILLING, INC	0-60)	
Print Name of Water Well Contractor	and License No.	Signatu	re of Water Well Contractor
			OCT 1 8 2010
· · · · ·	•	· .	


		A	£3	
	STATE WE	LL REPORT		
	I W		For Office Use Only:	
county: Lamar	Pump Installer's	Completion Report of Environmental Quality	Aquifer:	
Dennik #	Office of Land an	d Water Résources		
Driller: Gary Rayborn	P.O. Bo Jackson MS	ox 10631 \$ 39289-0631	Well #:	
	(601)9	61-5210	Elevation:	
Date completed:	• •	-6938 (fax)		
This report should be prepared by the	e pump installer in detail	and filed with the Departm	ent within 30 days of the	
installation of pump. Well Owner Informati		W	'ell Location	
Owner Name: Penn-Va Oil	3 Gaston	Latitude:	Longitude:	
Owner Name: <u>PPN - Va Un</u>	C. 1.80)			
Mailing Address: 840 Gess	ner Suiteau		one): Conventional Survey,	
DEPT AP	-300	USGS quad, Hand-held GPS, Survey-grade GPS		
HOUSTON T	x 77024	1/4 1/4 Sec	23 Twn IN Rng 16W	
City State	Zip Code			
		Distance Direction	of Baxteruille	
Telephone No. (423) 723-00	281	4.5 Miles 2	of parterone	
		I		
Pump Type			Power Type Circle one	
Circle one				
Air Lift Jet	Submersible	Diesel Engine Gas	onic Engine	
Bucket Piston	Turbine	Electric Motor Ha		
	Flowing Well	Windmill Ot	her (specify):	
Comment		Horse Power Rating of Mo	otor:5HP	
Other (specify):	10	Setting Depth:	189 feet	
Date I thinp motimizer	-10			
Rated Pump Capacity:	Gallons Per Minute	Number of Stages:		
Pump Test Dat	a	Method of	f Measuring Water Level Circle one	
-			· · ·	
Date Well Tested:		Air Line Electric	Measuring Line Steel Tape	
Static Water Level (A): <u>140</u> Fe		Other (specify):		
Pumping Water Level (B):Fe				
	eet Below Land Surface	For flowing well, measur	red shut in head:feet	
		Well vielded	O GPM with a drawdown of	
Test Pumping Rate: (0 ()			fterhours of pumping	
Duration of Pump Test (minimum 4 hour	rs):hours	feet a	Iternours or pumping	
	the sector and the has	st of my knowledge.	Ν.	
I HEREBY CERTIFY that the above sta	α α β β β			
Gary Rayborn		Signature of Pu	Imp Installer	
Print Name of Pump Installer and Licen	se NO. (II applicable)			
			OCT 1 8-2010	
	• ••	•	RY-OLWR	
			DI ULVIN	

If well telescopes please sketch below and show depths.

Ground Level

· · ·	Description of Formations Encountered	From	To
	Red sandy clay	10	40
	SAND WICIAY STREAKS	40	80
	Pea Gravel & clay strks	80	130
	Red Sandy Clay	130	160
	FINE SAND	160	260
	Coarse SAND	200	260
	·		
			_
			+
		<u> </u>	

If more than one screen, show location of each on sketch

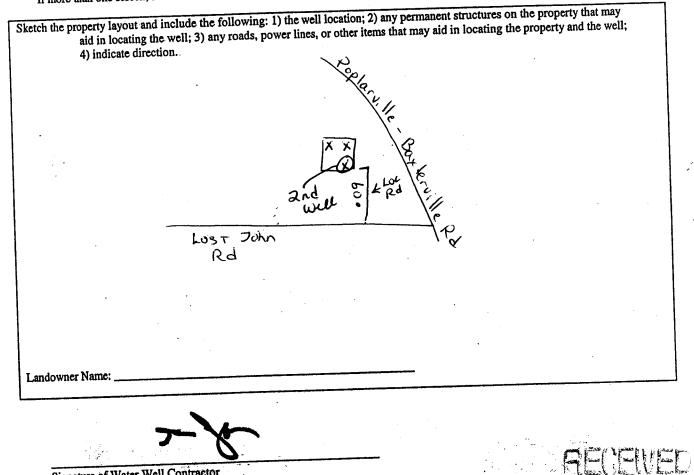

OCT 1.8 2010

BY.OLWA

Signature of Water Well Contractor