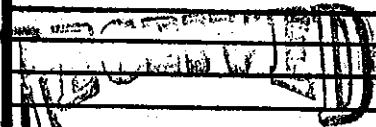


LAMAR
M 2001

MISSISSIPPI DEPARTMENT OF NATURAL RESOURCES
Bureau of Land and Water Resources
Southport Mall
P.O. Box 10631
Jackson, Mississippi 39209
WATER WELL DRILLERS LOG

3-14-1986 Tom Griffith Well Ser LAMAR
date well completed firm name county well located

LANDOWNER: <u>Ollie May Thompson</u>	description of formations encountered		from	to
<u>RR. 1</u>				
<u>Purvis, Miss.</u> (mailing address)	<u>Sand & gravel</u>		<u>0</u>	<u>27</u>
	<u>Chalk</u>		<u>27</u>	<u>170</u>
	<u>soft sand</u>		<u>170</u>	<u>200</u>
WELL LOCATION:				
sec. <u>4</u> T <u>1</u> N R <u>16</u> E				
<u>10</u> miles <u>W</u> of <u>Purvis</u>				
(distance) (direction) (nearest town)				
WELL PURPOSE: <u>Home</u> (home, irrigation, municipal, industrial)				
WELL COMPLETION DATA:				
(1) diameter (inches) <u>4"</u>				
(2) total depth (feet) <u>200</u>				
(3) static water level (feet) <u>55</u> <u>below</u> above top of ground.				
(4) casing <u>PVC</u> , <u>185</u> cu (material) (depth)				
<u>NA</u> if telescope see back. (size)				
(5) screen <u>15</u> , <u>185</u> (length) (depth to top)				
<u>4"</u> , <u>PVC</u> (size) (material)				
(6) pump <u>1/2</u> , <u>10</u> (HP) (yield gpm)				
<u>Elec.</u> (type power)				
(7) electric log <u>no</u> (yes or no)				
<u>M/L</u> (organization running log)				
(8) how well bottom plugged <u>BWV</u>				
DRILLERS REMARKS:				
				
APR - 9 1986				
Department of Natural Resources Bureau of Land & Water Resources				