

LAMAR MISSISSIPPI BOARD OF WATER COMMISSIONERS

N 25
11-60

WATER WELL DRILLERS LOG

N 301

Date: Nov, 1960, Driller: Les Sabber County Lamar

(Name)

(1) Owner of Land: Henny Moller
(Name)
Lumberton Miss
(Address)

Description & Color of Materials Sand, Clay, Red Clay, Shell, etc.	Thick- ness Feet	Depth Feet
<u>Sand Clay</u>	<u>30</u>	<u>0-30</u>
<u>Red Sand</u>	<u>22</u>	<u>30-52</u>

(2) Location: NE 1/4, NE 1/4, Sec. 23 T 1 R 15
3 miles North West of Lumberton
(distance) (direction) (Nearest Town)

(3) Topography: (Hilly) (Flat) (Level)

(4) Purpose of Well: Home & Farm
(Domestic Irrigation
Municipal, Industrial, Other)


Information upon completion of well:

- (1) Diameter 2 inches.
- (2) Total Depth 52 feet.
- (3) Water Level 30 feet below top of ground.
- (4) Cased to 47 ft, Size 2"
- (5) Screen: Size 60 Mesh, Length 5 ft
- (6) Were any formations sealed against pollution?
 yes, no.

If YES depth of formation _____

Why _____

Drillers Remarks: _____

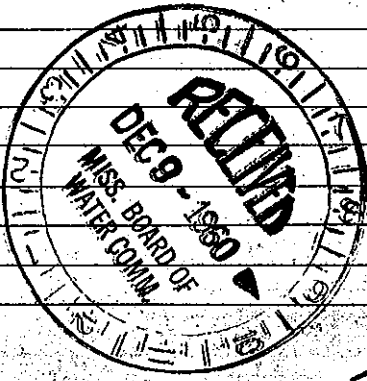

(Use Back Side)

Well No. 77