

LA-MAR MISSISSIPPI BOARD OF WATER COMMISSIONERS

N 31 *Ins. info to locate*  
7-27-60

WATER WELL DRILLERS LOG

**CODED**

Date: July 27, 19 60 Driller: Leo Sabes County Stamand  
(Name)


(1) Owner of Land:	Description & Color of Materials Sand, Clay, Red Clay, Shell, etc.	Thick- ness Feet	Depth Feet
<u>Artee</u> (Name) <u>Sumberton, Miss.</u> (Address)	<u>White clay</u> <u>clay</u>	<u>20</u>	<u>6-20</u> <u>65' 20-80'</u>
(2) Location: <u>1/4, 1/4, Sec. 1 T15R</u>			
<u>1 1/2 miles South of Sumberton</u> (distance) (direction) (Nearest Town)			
(3) Topography: <input checked="" type="checkbox"/> (Hilly) <input type="checkbox"/> (Flat) <input type="checkbox"/> (Level)			
(4) Purpose of Well: <u>Home Use</u> (Domestic Irrigation, Municipal, Industrial, Other)			

Information upon completion of well:

- (1) Diameter 4 inches.
- (2) Total Depth 85' feet.
- (3) Water Level 20 feet below top of ground.
- (4) Cased to 85 ft, Size 4"
- (5) Screen: Size 6 ft, Length 6 ft.
- (6) Were any formations sealed against pollution?  
\_\_\_\_\_ yes,  no.

If YES depth of formation \_\_\_\_\_  
Why \_\_\_\_\_  
Drillers Remarks: \_\_\_\_\_

**CODED**

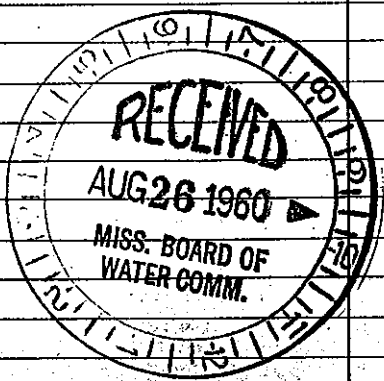

Well No. 2

(Use Back Side)