

LAMAR MISSISSIPPI BOARD OF WATER COMMISSIONERS

N32
10-60

N300

WATER WELL DRILLERS LOG

Date: Oct, 1960, Driller: Les Padon County: Lamar
(Name)

(1) Owner of Land: Estella Davis
(Name)
Lumberton Miss
(Address)

Description & Color of Materials Sand, Clay, Red Clay, Shell, etc.	Thick- ness Feet	Depth Feet
<u>Red Clay</u>	<u>20</u>	<u>0-20</u>
<u>Red Sand</u>	<u>48</u>	<u>20-68</u>

(2) Location: 1/4, 1/4, Sec. T R,
1 miles NW, of Lumberton
(distance) (direction) (Nearest Town)


(3) Topography: (Hilly) (Flat) (Level)

(4) Purpose of Well: Home use
(Domestic Irrigation
Municipal, Industrial, Other)

Information upon completion of well:

- (1) Diameter 2 inches.
- (2) Total Depth 65 feet.
- (3) Water Level 25 feet below top of ground.
- (4) Cased to 59, Size 2"
- (5) Screen: Size 2x60, Length 5'
- (6) Were any formations sealed against pollution?
no.

If YES depth of formation _____
Why _____
Drillers Remarks: _____

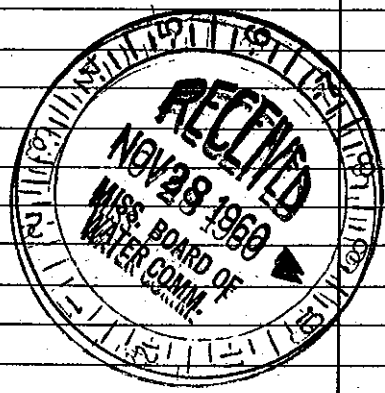

Well No. 18

(Use Back Side)