

LAMAR MISSISSIPPI BOARD OF WATER COMMISSIONERS

N 33

4-28-62

WATER WELL DRILLERS LOG

Lamar

Date: 4-28, 1962, Driller: Leo Palmer County: Lamar
(Name)

(1) Owner of Land: O W Hale Jr.
(Name)
Lumberton Miss
(Address)

Description & Color of Materials Sand, Clay, Red Clay, Shell, etc.	Thick- ness Feet	Depth Feet
<u>White Clay</u>	<u>35</u>	<u>0-35</u>
<u>fine sand clay</u>	<u>21</u>	<u>35-56</u>
<u>Sand</u>	<u>61</u>	<u>56-117</u>
<u>Gravel</u>	<u>5</u>	<u>117-122</u>

(2) Location: NE 1/4, NE 1/4, Sec. 28 T. 1 R. 15
2 1/2 miles West, of Lumberton
(distance) (direction) (Nearest Town)

(3) Topography: (Hilly) (Flat) (Level)

(4) Purpose of Well: Domestic Use
(Domestic Irrigation, Municipal, Industrial, Other)


Information upon completion of well:

- (1) Diameter 2 inches.
- (2) Total Depth 122 feet.
- (3) Water Level 42 feet below top of ground.
- (4) Cased to 117, Size 2"
- (5) Screen: Size 10, Length 5
- (6) Were any formations sealed against pollution?
no.

If YES depth of formation _____

Why _____

Drillers Remarks: _____

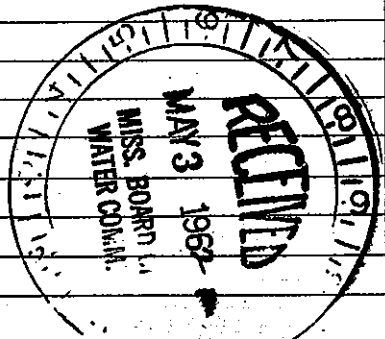

Well No. 70

(Use Back Side)

Mail this copy to Board of Water Commissioners 429 Miss. St. Jackson, Miss.