

LAMAR MISSISSIPPI BOARD OF WATER COMMISSIONERS

N34
2-27-62

WATER WELL DRILLERS LOG

Date: 2/27/62, 1962; Driller: Geo. L. Loper County: Lamar
(Name)

(1) Owner of Land:	Description & Color of Materials Sand, Clay, Red Clay, Shell, etc.	Thick- ness Feet	Depth Feet
<u>Vanda Jenkins</u> (Name)	<u>Clay</u>	<u>20</u>	<u>0-25</u>
<u>Lumberton, Miss.</u> (Address)	<u>slightly sandy</u>	<u>30</u>	<u>25-55</u>
(2) Location: <u>1/4</u> , <u>1/4</u> , Sec. <u>T</u> , R <u>R</u>	<u>sand</u>	<u>45</u>	<u>55-100</u>
<u>6</u> miles <u>North</u> of <u>Lumberton</u>			
(distance) (direction) (Nearest Town)			
(3) Topography: <input checked="" type="checkbox"/> (Hilly) <input type="checkbox"/> (Flat) <input type="checkbox"/> (Level)			
(4) Purpose of Well: <u>Home use</u>			
(Domestic Irrigation, Municipal, Industrial, Other)			


Information upon completion of well:

- (1) Diameter 2 inches.
- (2) Total Depth 100 feet.
- (3) Water Level 60 feet below top of ground.
- (4) Cased to 95, Size 2"
- (5) Screen: Size 10, Length 5'
- (6) Were any formations sealed against pollution?
 yes, no.

If YES depth of formation _____

Why _____

Drillers Remarks: _____

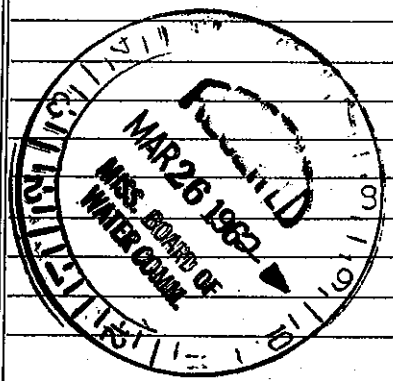

02 Well No.

(Use Back Side)

Mail this copy to Board of Water Commissioners 429 Miss. St. Jackson, Miss.