

MISSISSIPPI BOARD OF WATER COMMISSIONERS

CODED

WATER WELL DRILLERS LOG

Date: Dec 26, 1961, Driller: Leo Fisher County: Lamar
 (Name)


(1) Owner of Land:	Description & Color of Materials Sand, Clay, Red Clay, Shell, etc.	Thick- ness Feet	Depth Feet
(Name) <u>D. L. Royal</u> (Address) <u>Lumberton Miss</u>	<u>Clay</u>	<u>31</u>	<u>0-31</u>
(2) Location: <u>1/4</u> , <u>1/4</u> , Sec. <u>19</u> T. <u>1</u> R. <u>19</u> <u>2</u> miles <u>North</u> , of <u>Lumberton</u> (distance) (direction) (Nearest Town)	<u>Sand</u>	<u>11</u>	<u>31-42</u>
(3) Topography: <input checked="" type="checkbox"/> (Hilly) <input type="checkbox"/> (Flat) <input type="checkbox"/> (Level)			
(4) Purpose of Well: <u>Home Use</u> (Domestic Irrigation Municipal, Industrial, Other)			

Information upon completion of well:

- (1) Diameter 2 inches.
- (2) Total Depth 42 feet.
- (3) Water Level 25 feet below top of ground.
- (4) Cased to 38, Size 2"
- (5) Screen: Size 010, Length 4'
- (6) Were any formations sealed against pollution?
 yes, no.

If YES depth of formation _____
 Why _____
 Drillers Remarks: _____

CODED

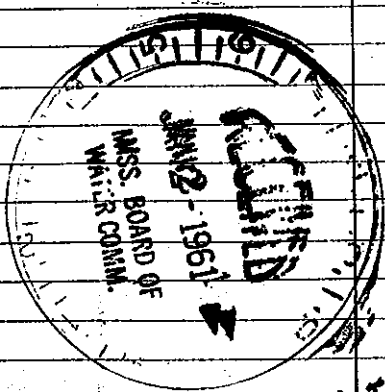

(Use Back Side)

Well No. 52