

LAUD. MISSISSIPPI BOARD OF WATER COMMISSIONERS

A4

8-21-63


WATER WELL DRILLERS LOG

Date: 8-21, 1963, Driller: McDonald & Hill County, Landdale
(Name)

(1) Owner of Land: Jimmie Paulsen (Name)	Description & Color of Materials Sand, Clay, Red Clay, Shell, etc.	Thick- ness Feet	Depth Feet
Rt. # 1, Collinsville, Mo. (Address)	Clay shale	0	15
(2) Location: 1/4, 1/4, Sec 25 8N 14E T R	w/ sand st.	15	50
1 miles East, of Collinsville (distance) (direction) (Nearest Town)	w/ sand st.	55	63
(3) Topography: Hilly (Hilly) (Flat) (Level)	w/ sand st.	63	75
(4) Purpose of Well: Domestic (Domestic Irrigation Municipal, Industrial, Other)	sand	75	84
	shale w/ sand st.	97	97
	darker shale st.	100	118

Information upon completion of well:

- (1) Diameter 3 7/8 inches.
- (2) Total Depth 118 feet.
- (3) Water Level 50 feet below top of ground.
- (4) Cased to 110, Size 2"
- (5) Screen: Size 2", Length 6'
- (6) Were any formations sealed against pollution?
_____ yes, _____ no.

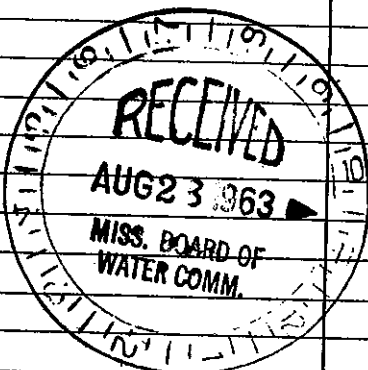

If YES depth of formation _____
Why _____
Drillers Remarks: _____

Well No.
100

(Use Back Side)

Mail this copy to Board of Water Commissioners 429 Miss. St. Jackson, Miss.