

L.A.U.O. MISSISSIPPI BOARD OF WATER COMMISSIONERS

A 5

7-25-65 WATER WELL DRILLERS LOG

3

Date: 7-25, 1964, Driller: Bob Williams County, Lauderdale
(Name)

(1) Owner of Land: Willie E. Taylor (Name) Pt. 1, Collinsville, Miss. (Address)		Description & Color of Materials Sand, Clay, Red Clay, Shell, etc.	Thick- ness Feet	Depth Feet
(2) Location: 1/4, 1/4, Sec. 33 8N 14E T. R.		Blue clay	0.5	1-6.5
10 miles N.W. of Meridian. (distance) (direction) (Nearest Town)		fine white sand	2.5	6.5-9.0
(3) Topography: hilly (Hilly) (Flat) (Level)		Blue Clay	2.0	9.0-11.0
(4) Purpose of Well: Domestic (Domestic Irrigation Municipal, Industrial, Other)		gray sand	5	11.0-11.5
		Blue Clay	1.0	11.5-12.5
		gray sand	2.4	12.5-14.9


Information upon completion of well:

- (1) Diameter 2 inches.
- (2) Total Depth 149 feet.
- (3) Water Level 4.5 feet below top of ground.
- (4) Cased to 97, Size 2"
- (5) Screen: Size 0, Length _____
- (6) Were any formations sealed against pollution?
yes, no.

If YES depth of formation _____

Why surface water

Drillers Remarks: _____

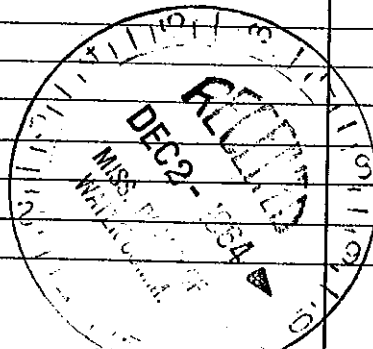

(Use Back Side)

Well No.

Mail this copy to Board of Water Commissioners 429 Miss. St. Jackson, Miss.