

LAUD. MISSISSIPPI BOARD OF WATER COMMISSIONERS

A6
4-21-64

WATER WELL DRILLERS LOG

Date: 4-21, 1964, Driller: M^r. Donald d Hill Jr County: Lauderdale
(Name)


(1) Owner of Land: Edward VANCE
(Name)
Rt. #1, Collinsville, Miss.
(Address) 8N 14E

(2) Location: 1/4, 1/4, Sec. 7 T. R.
15 miles N WEST of MERIDIAN,
(distance) (direction) (Nearest Town)

(3) Topography: X
(Hilly) (Flat) (Level)

(4) Purpose of Well: DOMESTIC
(Domestic Irrigation
Municipal, Industrial, Other)

Description & Color of Materials Sand, Clay, Red Clay, Shell, etc.	Thick- ness Feet	Depth Feet
CLAY	0	12
SAND	12	40
SHALE	40	70
ROCK	70	71
SHALE	71	140
FINE SAND	140	174
SAND 10:12 5605"	174	190

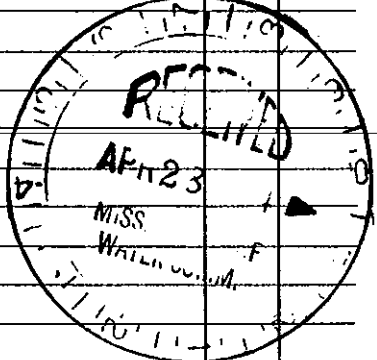

Information upon completion of well:

(1) Diameter: 3 7/8 inches. TEST HOLE

(2) Total Depth: 190' feet.

(3) Water Level: 82' feet below top of ground.

(4) Cased to: 180', Size: 2"

(5) Screen: Size 2", Length 10'

(6) Were any formations sealed against pollution?
_____ yes, _____ no.

If YES depth of formation _____

Why _____

Drillers Remarks: 190
60
11400

Well No.

(Use Back Side)

Mail this copy to Board of Water Commissioners 429 Miss. St. Jackson, Miss.