

LAUD.
A7

WATER WELL DRILLERS LOG

19

Date: 4/25-64, Driller: Bob Williams County Lauderdale
(Name)

(1) Owner of Land: A. L. Houston
(Name)
Collinsville
(Address)

(2) Location: SE 1/4, NE 1/4, Sec. 27 T. 8 R. 14
12 miles NW of Mendis
(distance) (direction) (Nearest Town)

(3) Topography: Hilly
(Hilly) (Flat) (Level)

(4) Purpose of Well: Domestic
(Domestic Irrigation
Municipal, Industrial, Other)

Description & Color of Materials Sand, Clay, Red Clay, Shell, etc.	Thick- ness Feet	Depth Feet
<u>Red clay</u>	<u>15</u>	<u>1-15</u>
<u>Blue Clay</u>	<u>85</u>	<u>15-100</u>
<u>fine gray sand</u>	<u>55</u>	<u>100-155</u>
<u>Blue Clay</u>	<u>45</u>	<u>155-200</u>
<u>gray sand</u>	<u>10</u>	<u>200-210</u>
<u>Blue Clay</u>	<u>30</u>	<u>210-240</u>
<u>white sand</u>	<u>5</u>	<u>240-245</u>
<u>Blue Clay</u>	<u>210</u>	<u>245-475</u>
<u>fine gray sand</u>	<u>27</u>	<u>475-475</u>

Information upon completion of well:

(1) Diameter 2 inches.

(2) Total Depth 475 feet.

(3) Water Level 103 feet below top of ground.


(4) Cased to 162 ft., Size 2 in.

(5) Screen: Size 20, Length _____.

(6) Were any formations sealed against pollution?
 yes, _____ no.

If YES depth of formation 100-155 ft.
Why sand too fine for screening

Drillers Remarks: _____

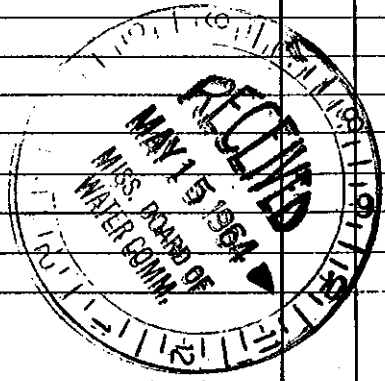

(Use Back Side)

Well No.

Mail this copy to Board of Water Commissioners 429 Miss. St. Jackson, Miss!