

LAUD. WATER WELL DRILLERS LOG

Date: 7-11-72, 1964, Driller: Bob Williamson County Lauderdale
 (Name)


(1) Owner of Land: C. O. Johnson
 (Name)
Collinsville, Rt. 3
 (Address)
N 1/2 - E 1/2 - NW 1/4
 (2) Location: 1/4, 1/4, Sec. 27 T. 8 R. 14
13 miles N. W. of Muskegon
 (distance) (direction) (Nearest Town)
 (3) Topography: Hilly
 (Hilly) (Flat) (Level)
 (4) Purpose of Well: Domestic
 (Domestic Irrigation, Municipal, Industrial, Other)

Description & Color of Materials Sand, Clay, Red Clay, Shell, etc.	Thick- ness Feet	Depth Feet
Red clay	10	1-10
White Chalk	10	10-20
Blue clay	90	20-110
fine white sand	50	110-160
Blue clay	40	160-200
fine white sand	5	200-205
Blue clay	45	205-250
fine gray sand	25	250-275
Blue clay	25	275-300
gray sand	10	300-310
Blue clay	7	310-317

Information upon completion of well:

(1) Diameter 2 inches.
 (2) Total Depth 317 feet.
 (3) Water Level 88 feet below top of ground.
 (4) Cased to 168, Size 2"
 (5) Screen: Size 0, Length _____
 (6) Were any formations sealed against pollution?
 yes, _____ no.

If YES depth of formation _____
 Why surface water
 Drillers Remarks: _____

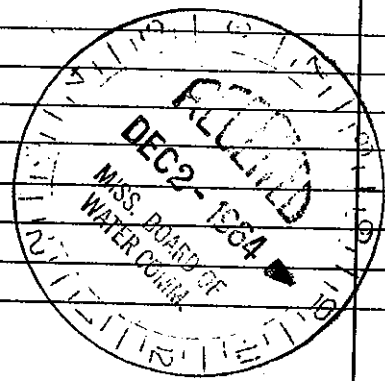

(Use Back Side)

Well No.

Retain this copy for your office files.