

LAUD.

A 9

7-22-64

WATER WELL DRILLERS LOG

Date: 7-22, 19 64, Driller: Bob Williamson County Lauderdale
(Name)

	Description & Color of Materials Sand, Clay, Red Clay, Shell, etc.	Thick- ness Feet	Depth Feet
(1) Owner of Land: <u>Harold Spence</u> (Name) <u>Collinsville, Miss.</u> (Address)	<u>Red Clay</u>	<u>10</u>	<u>1-10</u>
(2) Location: <u>1/4</u> , <u>1/4</u> , Sec. <u>20</u> <u>8N 14E</u> (distance) (direction) (Nearest Town) <u>13</u> miles <u>N.W.</u> of <u>Meridian</u> (distance) (direction) (Nearest Town)	<u>Blue Clay</u>	<u>20</u>	<u>10-30</u>
	<u>sand</u>	<u>20</u>	<u>30-50</u>
	<u>Blue clay</u>	<u>10</u>	<u>50-60</u>
	<u>gray sand</u>	<u>7</u>	<u>60-67</u>
(3) Topography: <u>Hilly</u> (Hilly) (Flat) (Level)			
(4) Purpose of Well: <u>Domestic</u> (Domestic irrigation Municipal, Industrial, Other)			

Information upon completion of well:

(1) Diameter 2 inches.

(2) Total Depth 67 feet.

(3) Water Level 24 feet below top of ground.

(4) Cased to 63, Size 2"


(5) Screen: Size 2", Length 4'

(6) Were any formations sealed against pollution?
 yes, no.

If YES depth of formation _____

Why _____

Drillers Remarks: _____

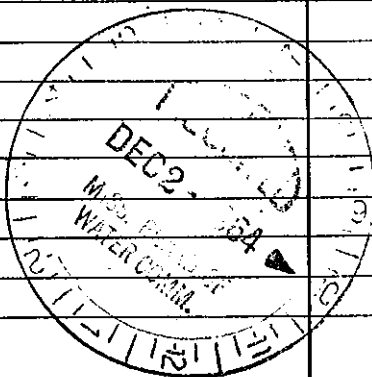

(Use Back Side)

Well No. _____

Mail this copy to Board of Water Commissioners 429 Miss. St. Jackson, Miss.