

LAUD.

A 10

8-28-64

WATER WELL DRILLERS LOG

Date: 8/28, 1964, Driller: Bob Williams County Tandridge
(Name)

(1) Owner of Land:	Description & Color of Materials Sand, Clay, Red Clay, Shell, etc.	Thick- ness Feet	Depth Feet
<u>W. N. Williams</u> (Name) <u>Collinsville, Miss.</u> (Address)	<u>Blue clay</u>	<u>60</u>	<u>1-60</u>
(2) Location: <u>1/4</u> , <u>1/4</u> , Sec. <u>21</u> <u>8 N 1 E</u> T. <u>R.</u>	<u>gray sand</u>	<u>30</u>	<u>60-90</u>
<u>12</u> miles <u>N.W.</u> of <u>Mendie</u> , (distance) (direction) (Nearest Town)	<u>Blue clay</u>	<u>180</u>	<u>90-270</u>
(3) Topography: <u>Hilly</u> (Hilly) (Flat) (Level)	<u>gray sand</u>	<u>20</u>	<u>270-290</u>
(4) Purpose of Well: <u>Domestic</u> (Domestic Irrigation Municipal, Industrial, Other)	<u>Blue clay</u>	<u>50</u>	<u>290-340</u>
	<u>gray sand</u>	<u>20</u>	<u>340-360</u>


Information upon completion of well:

- (1) Diameter 2 inches.
- (2) Total Depth 360 feet.
- (3) Water Level 100 feet below top of ground.
- (4) Cased to 210, Size 2"
- (5) Screen: Size 0, Length _____
- (6) Were any formations sealed against pollution?
 yes, no.

If YES depth of formation 0

Why surface water

Drillers Remarks:

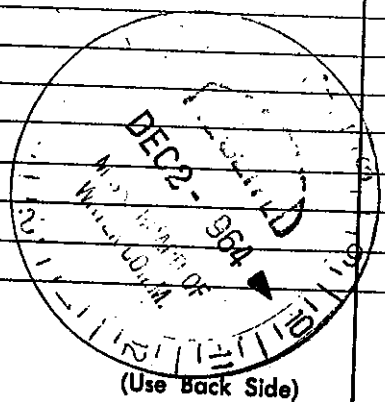

Well No. _____

Retain this copy for your office files.