

LAUD.
A 14

WATER WELL DRILLERS LOG

Date: 8-19-64, 1964, Driller: Bob Williams County Lauderdale
(Name)


(1) Owner of Land: Lewis May
(Name)
Collinsville Rt. 3
(Address)
(2) Location: N 1/4, Lot 17, Sec. 3 T8R14
20 miles North, of Meridian
(distance) (direction) (Nearest Town)
(3) Topography: Hilly
(Hilly) (Flat) (Level)
(4) Purpose of Well: Domestic
(Domestic Irrigation
Municipal, Industrial, Other)

Description & Color of Materials Sand, Clay, Red Clay, Shell, etc.	Thick- ness Feet	Depth Feet
<u>Red sand</u>	<u>2.0</u>	<u>1-20</u>
<u>Blue clay</u>	<u>1.60</u>	<u>20-180</u>
<u>gray sand</u>	<u>50</u>	<u>180-230</u>

Information upon completion of well:

(1) Diameter 2 inches.
(2) Total Depth 230 feet.
(3) Water Level 47 feet below top of ground.
(4) Cased to 120, Size 2"
(5) Screen: Size 0, Length _____
(6) Were any formations sealed against pollution?
✓ yes, _____ no.

If YES depth of formation _____
Why surface water
Drillers Remarks: _____

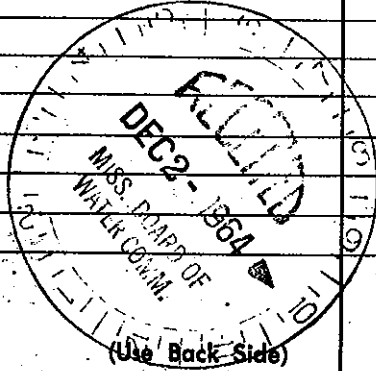

Well No. _____

is copy for your office files.