

LAUDERDALE

A 19

7-7-66

MISSISSIPPI BOARD OF WATER COMMISSIONERS

4

WATER WELL DRILLERS LOG

Date: 7-7, 1966, Driller: McDONALD + HILL County LAUD.

(When well drilled)

(Name)

(Where well is located)

(1) Owner of Land: LEWIS GEORGE (Name) COLLINSVILLE, RT #1 (Address)

(2) Location: 1/4, 1/4, Sec. 7 T. R. 5 miles NORTH of Collinsville (distance) (direction) (Nearest Town)


(3) Topography: Hilly (Hilly) (Flat) (Level)

(4) Purpose of Well: DOMESTIC (Domestic Irrigation Municipal, Industrial, Other)

Table with 4 columns: Description & Color of Materials, Thickness Feet, Depth Feet. Rows include CLAY, SOFT SHALE, SOFT TO M SHALE, M TO H SHALE, G SAND, SOFT SHALE, M SHALE, SOFT SHALE GREEN, FINE SAND, M SHALE LIMY.

Information upon completion of well:

- (1) Diameter 4 inches. (2) Total Depth 200 feet. (3) Water Level 58 feet below top of ground. (4) Cased to 10.5, Size 4. (5) Screen: Size, Length. (6) Were any formations sealed against pollution? yes, no.

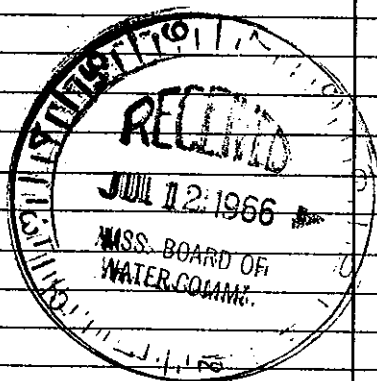

If YES depth of formation. Why. Drillers Remarks. Yield in gpm. Size pump. Type power.

Mail this copy to Board of Water Commissioners 429 Miss. St. Jackson, Miss.