

LAUD. MISSISSIPPI BOARD OF WATER COMMISSIONERS

A 20


12-7-63

WATER WELL DRILLERS LOG

Date: 12-7, 1963, Driller: M^{rs} DONALD HILL County Lauderdale

(Name)

		Description & Color of Materials Sand, Clay, Red Clay, Shell, etc.	Thick- ness Feet	Depth Feet
(1) Owner of Land: <u>JOE NOTT</u> (Name)	<u>COLLINSVILLE R# 2</u> (Address)	<u>CLAY</u>	<u>0</u>	<u>20</u>
		<u>SANDY CLAY</u>	<u>20</u>	<u>52</u>
(2) Location: <u>1/4</u> , <u>1/4</u> , Sec. <u>4</u> <u>8N 14E</u> T. R.	<u>18</u> miles <u>NORTH</u> , of <u>MERIDIAN</u> (distance) (direction) (Nearest Town)	<u>SHALE</u>	<u>52</u>	<u>147</u>
		<u>SANDY SHALE</u>	<u>147</u>	<u>162</u>
(3) Topography: <u>X</u> (Hilly) (Flat) (Level)		<u>FINE SAND</u>	<u>162</u>	<u>180</u>
		<u>SHALE</u>	<u>180</u>	<u>205</u>
(4) Purpose of Well: <u>Domestic</u> (Domestic Irrigation Municipal, Industrial, Other)		<u>SHALE</u>	<u>205</u>	<u>311</u>
		<u>ROCK</u>	<u>311</u>	<u>312</u>
		<u>FINE SAND ST SHALE</u>	<u>312</u>	<u>350</u>
Information upon completion of well:				
(1) Diameter <u>3"</u> inches.				
(2) Total Depth <u>350</u> feet.				
(3) Water Level <u>87'</u> feet below top of ground.				
(4) Cased to <u>168</u> , Size <u>3"</u>				
(5) Screen: Size _____, Length _____				
(6) Were any formations sealed against pollution? <u>no.</u>				
If YES depth of formation _____				
Why _____				
Drillers Remarks: _____				

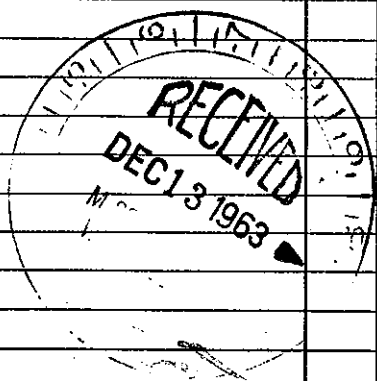

Well No.

(Use Back Side)

Mail this copy to Board of Water Commissioners 429 Miss. St. Jackson, Miss.