

LAUD. MISSISSIPPI BOARD OF WATER COMMISSIONERS

A22

12-8-64

WATER WELL DRILLERS LOG

Date: 12-8, 1964, Driller: Bob Williamson County Lauderdale
(Name)

(1) Owner of Land:	Description & Color of Materials Sand, Clay, Red Clay, Shell, etc.	Thick- ness Feet	Depth Feet
C. Culpepper (Name) Collinsville, Miss. (Address)	Red Clay	5	1-5
8 N 14 E	White sand	25	5-30
(2) Location: 1/4, 1/4, Sec. 1 T. R.	Blue clay	150	30-180
20 miles N.W. of Mendon (distance) (direction) (Nearest Town)	gray sand	32	180-212
(3) Topography: Kelly (Hilly) (Flat) (Level)			
(4) Purpose of Well: Domestic (Domestic Irrigation Municipal, Industrial, Other)			


Information upon completion of well:

- (1) Diameter 2 inches.
- (2) Total Depth 212 feet.
- (3) Water Level 101 feet below top of ground.
- (4) Cased to 120, Size 2"
- (5) Screen: Size 0, Length _____
- (6) Were any formations sealed against pollution?
 yes, _____ no.

If YES depth of formation _____

Why surface water

Drillers Remarks: _____

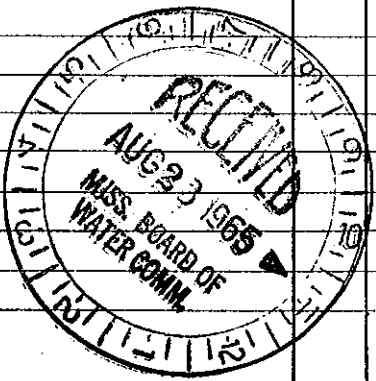

Well No. _____

(Use Back Side)

Retain this copy for your office files.