

LAUD.
A 24

MISSISSIPPI BOARD OF WATER COMMISSIONERS

4-17-65

WATER WELL DRILLERS LOG

Date: 4-17, 1965, Driller: Bob Wilkinson County Laud.
(Name)

(1) Owner of Land: Edward Moffett
(Name)
Collinsville, R.T.
(Address)

(2) Location: 1/4, 1/4, Sec. 14 80 10 T. R.
18 miles N.W. of Meridia,
(distance) (direction) (Nearest Town)

(3) Topography: Hilly
(Hilly) (Flat) (Level)

(4) Purpose of Well: domestic
(Domestic Irrigation
Municipal, Industrial, Other)

Description & Color of Materials Sand, Clay, Red Clay, Shell, etc.	Thick- ness Feet	Depth Feet
<u>Red clay</u>	<u>5</u>	<u>1-5</u>
<u>White sand</u>	<u>25</u>	<u>5-30</u>
<u>Blue clay</u>	<u>76</u>	<u>30-106</u>
<u>gray sand</u>	<u>22</u>	<u>106-128</u>

Information upon completion of well:

(1) Diameter 2 inches.

(2) Total Depth 128 feet.

(3) Water Level 73 feet below top of ground.

(4) Cased to 95, Size 2"


(5) Screen: Size _____, Length 0

(6) Were any formations sealed against pollution?
 yes, _____ no.

If YES depth of formation _____

Why _____

Drillers Remarks: _____

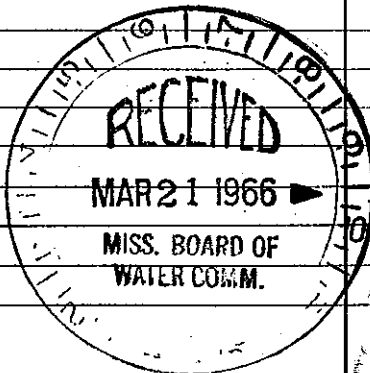

(Use Back Side)

Well No.

Mail this copy to Board of Water Commissioners 429 Miss. St. Jackson, Miss