

LAVO.
A 25

MISSISSIPPI BOARD OF WATER COMMISSIONERS

3-21-66 WATER WELL DRILLERS LOG

Date: 3-21, 1966, Driller: McDonald & Hill, Inc. County: Lauderdale
(Name)

(1) Owner of Land:	Description & Color of Materials Sand, Clay, Red Clay, Shell, etc.	Thick- ness Feet	Depth Feet
Raymond SCITZ (Name)	CLAY	0	16
Collinsville MISS (Address)	SAND CLAY	16	65
Location: 1/4, 1/4, Sec 21 T. R. 8N14E	SHALE	65	95
12 miles N.W. of Meridian	SANDY	95	110
(distance) (direction) (Nearest Town)	SHALE	110	190
(3) Topography: X	SAND	190	210
(Hilly) (Flat) (Level)	SANDY SHALE	210	240
(4) Purpose of Well: DOMESTIC (Domestic Irrigation Municipal, Industrial, Other)			

Information upon completion of well:

(1) Diameter: 3 1/2 TEST HOLE inches.

(2) Total Depth: 240' feet.

(3) Water Level: 74' feet below top of ground.

(4) Cased to 126, Size 2"


(5) Screen: Size _____, Length _____

(6) Were any formations sealed against pollution?
_____ yes, _____ no.

If YES depth of formation _____

Why _____

Drillers Remarks: _____

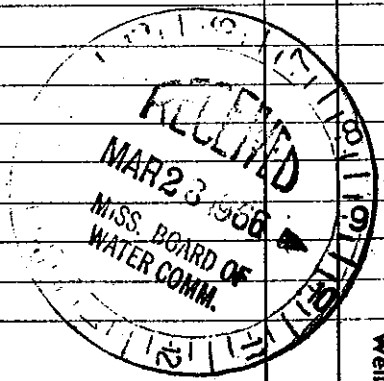

Well No.

(Use Back Side)

Mail this copy to Board of Water Commissioners 429 Miss. St. Jackson, Miss