

LAUD.

MISSISSIPPI BOARD OF WATER COMMISSIONERS

A 25

WATER WELL DRILLERS LOG

6-20-64

Date: 6-20, 1964, Driller: Bob Williams County Lauderdale

(Name)

(1) Owner of Land: <u>Joe E. Hanna</u> (Name)	Description & Color of Materials Sand, Clay, Red Clay, Shell, etc.	Thick- ness Feet	Depth Feet
<u>Rt. 2, Meridian</u> (Address)	<u>Red clay</u>	<u>10</u>	<u>1-10</u>
(2) Location: <u>Unknown 8 N 1/4 E</u> <u>1/4, 1/4, Sec 26 T R</u>	<u>White chalk</u>	<u>10</u>	<u>10-20</u>
<u>10</u> miles <u>N.W.</u> of <u>Meridian</u> (distance) (direction) (Nearest Town)	<u>fine white sand</u>	<u>10</u>	<u>20-30</u>
(3) Topography: <u>Hilly</u> (Hilly) (Flat) (Level)	<u>Blue clay</u>	<u>110</u>	<u>30-140</u>
(4) Purpose of Well: <u>Domestic</u> (Domestic Irrigation Municipal, Industrial, Other)	<u>White sand</u>	<u>51</u>	<u>140-191</u>


Information upon completion of well:

- (1) Diameter 4 inches.
- (2) Total Depth 191 feet.
- (3) Water Level 4 feet below top of ground.
- (4) Cased to 60, Size 4"
- (5) Screen: Size 0, Length \_\_\_\_\_
- (6) Were any formations sealed against pollution?  
 yes, \_\_\_\_\_ no.

If YES depth of formation \_\_\_\_\_

Why surface water

Drillers Remarks: \_\_\_\_\_

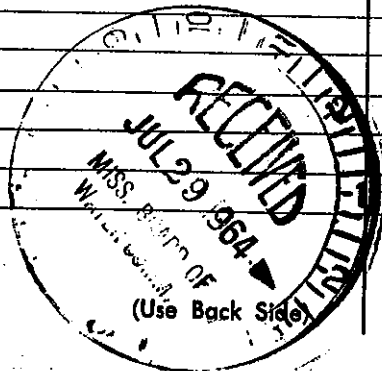

Well No. \_\_\_\_\_

this copy for your office files.