


LAUDERDALE
A 27
3-68

MISSISSIPPI
BOARD OF WATER COMMISSIONERS
416 North State Street
Jackson, Mississippi 39201

WATER WELL DRILLERS LOG

3-19-1968 date well completed
68 Jany Drilling Co. firm name
Lauder county well located

LANDOWNER:	description of formations encountered	from	to
Collinsville water assn.	Red & yellow clay	0	22
Collinsville, Miss.	sand & shale	22	100
(mailing address)	sandy	100	180
	blue dirt	180	240
WELL LOCATION:	sand & dirt	240	340
sec. 34 T. 8 N. R. 14 E.	sandy	340	400
8 miles NW of McN	sand & dirt Shales	400	490
(distance) (direction) (nearest town)	sand	490	505
WELL PURPOSE:	Hard dirt	505	560
(home, irrigation, municipal, industrial)	sandy	560	610
WELL COMPLETION DATA:	hard black dirt	610	641
(1) diameter (inches) 4"	sandy	641	655
(2) total depth (feet) 691'	good sand	655	691
(3) static water level (feet) 152' below top of ground.			
(4) casing 4" Blk. 631' (material) (depth)			
2 1/2" (size) if telescope see back.			
(5) screen 20' 671' (length) (depth to top)			
2 1/2" Stainless Steel (size) (material)			
(6) pump 3 H.P. 379 gpm (HP) (yield/gpm)			
Submerg (type power)			
(7) electric log No (yes or no)			
(organization running log)			
(8) how well bottom plugged			

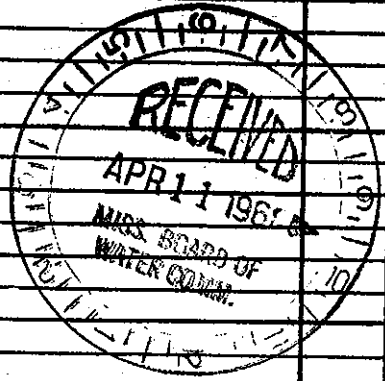

DRILLERS REMARKS: Well pumped 100 gpm with air. Coarse sand in bottom