

Land

A 29
6-65

MISSISSIPPI BOARD OF WATER COMMISSIONERS
CODED

WATER WELL DRILLERS LOG

Date: 6-5, 1965 Location: 1.51 Williamson County, Tenn.
(Name)

1. Owner of Land: Mable Davis
Name
Rt. 2 Collinsville, Miss.
(Address)

2. Location NN 1/4 SW 1/4 Sec. 1 T8 R14
20 miles N.W. of Indian
distance (Direction) (Nearest Town)

(3) Topography: flat
(Hilly) (Flat) (Level)

4. Purpose of Well: Domestic
(Domestic Irrigation
Municipal, Industrial, Other)

| Description & Color of Materials Sand, Clay, Red Clay, Shell, etc. | Thick- ness Feet | Depth Feet |
|---|------------------------|------------------|
| <u>Red sand</u> | <u>10</u> | <u>1-10</u> |
| <u>Blue clay</u> | <u>10</u> | <u>10-20</u> |
| <u>gray sand</u> | <u>5</u> | <u>20-25</u> |
| <u>Blue clay</u> | <u>16.5</u> | <u>25-41.5</u> |
| <u>white sand</u> | <u>2.0</u> | <u>43.5-45.5</u> |
| <u>Blue clay</u> | <u>2</u> | <u>47.5-49.5</u> |
| <u>gray sand</u> | <u>8</u> | <u>57.5-65.5</u> |


Information upon completion of well:

1) Diameter 4 inches.
6 feet.
feet below top of ground

2) Cased to 58, Size 4"

Were any formations sealed against pollution?
 yes

Remarks: no water

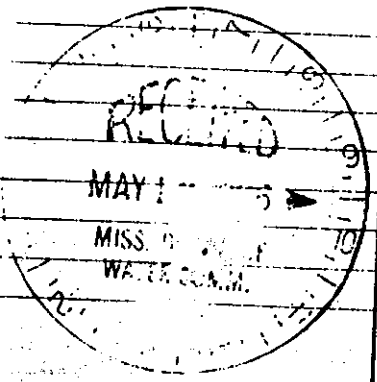

Well #