

MISSISSIPPI BOARD OF WATER COMMISSIONERS

WATER WELL DRILLERS LOG

CODED

LAUD.
A 52
9-28-60

Date: 9.28.60 19, Driller: McDonald Hill County: Lauderdale
(Name)


(1) Owner of Land: E. A. Matthew
(Name)
Collinsville
(Address)
(2) Location: 28 8 14
1/4, 1/4, Sec. 8, T. 14, R. 14,
16 miles north of Meridian,
(distance) (direction) (Nearest Town)
(3) Topography: X
(Hilly) (Flat) (Level)
(4) Purpose of Well: Domestic
(Domestic Irrigation
Municipal, Industrial, Other)

| Description & Color of Materials Sand, Clay, Red Clay, Shell, etc. | Thick- ness Feet | Depth Feet |
|---|------------------------|---------------|
| Clay | 0 | 10 |
| sand | 10 | 12 |
| Clay | 12 | 18 |
| Marl | 18 | 80 |
| Marl | 80 | 175 |
| fine Marl | 175 | 187 |
| Sandy Marl | 187 | 208 |
| sand | 208 | 214 |
| Marl | 214 | 240 |
| Sandy Marl | 240 | 270 |
| fine sand | 270 | 300 |

Information upon completion of well:

(1) Diameter 3" inches.
(2) Total Depth 300' feet.
(3) Water Level 114' feet below top of ground.
(4) Cased to 147', Size 3"
(5) Screen: Size _____, Length _____
(6) Were any formations sealed against pollution?
_____ yes, _____ no.

CODED

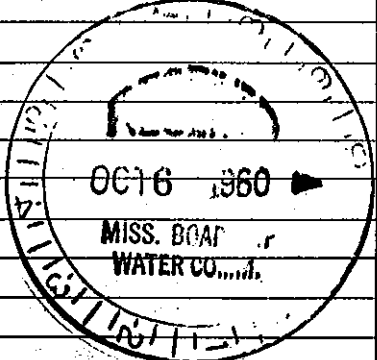

(Use Back Side)

Well No.

Mail this copy to Board of Water Commissioners 429 Miss. St. Jackson, Miss.