

LAUD.
A 53
9-27-61

MISSISSIPPI BOARD OF WATER COMMISSIONERS

WATER WELL DRILLERS LOG

CODED

Date: 9-27, 1961, Driller: McDONALD Mill County: LAUDERDALE
(Name)


(1) Owner of Land: MRS ONIE ANDERSON
(Name)
COLLINSVILLE MISS
(Address)
(2) Location: 1/4, 24 814 1/4 Sec. T. R.
14 miles N WEST, of Meridian
(distance) (direction) (Nearest Town)
(3) Topography: V
(Hilly) (Flat) (Level)
(4) Purpose of Well: DOMESTIC
(Domestic Irrigation
Municipal, Industrial, Other)

Description & Color of Materials Sand, Clay, Red Clay, Shell, etc.	Thick- ness Feet	Depth Feet
CLAY	0	10
SHALE	10	50
SANDY CLAY	50	65
SHALE	65	85
SOFT SHALE	85	105
SAND	105	140
SANDY SHALE	140	215
SHALE	215	255
SAND	255	270
SHALE	270	410
SANDY SHALE	410	450

Information upon completion of well:

(1) Diameter 4" inches.
(2) Total Depth 450' feet.
(3) Water Level 142' feet below top of ground.
(4) Cased to 231', Size 4"
(5) Screen: Size _____, Length _____
(6) Were any formations sealed against pollution?
_____ yes, _____ no.
If YES depth of formation _____
Why _____
Drillers Remarks: _____

CODED

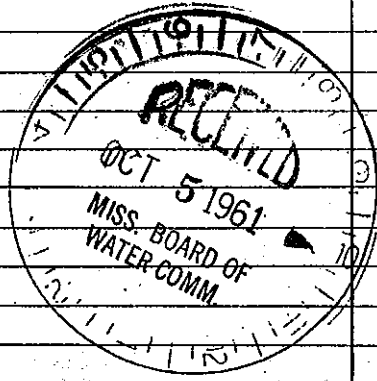

(Use Back Side)

Well No.

Retain this copy for your office files.