

LAUD. MISSISSIPPI BOARD OF WATER COMMISSIONERS

A54
8-13-62

WATER WELL DRILLERS LOG

CODED

Date: 8-13, 1962, Driller: McDonald - Hill County Louisiana
(Name)


(1) Owner of Land: H.F. Brooks
(Name)
Rt # 1 Collinsville
(Address)
(2) Location: 1/4, 23, 8, 14
23 8, 14
miles _____ of _____
(distance) (direction) (Nearest Town)
(3) Topography: Domestic
(Hilly) (Flat) (Level)
(4) Purpose of Well: Domestic
(Domestic Irrigation
Municipal, Industrial, Other)

Description & Color of Materials Sand, Clay, Red Clay, Shell, etc.	Thick- ness Feet	Depth Feet
<u>Clay</u>	<u>0</u>	<u>10</u>
<u>Sandy Clay</u>	<u>10</u>	<u>18</u>
<u>Shale</u>	<u>18</u>	<u>95</u>
<u>fine sand</u>	<u>95</u>	<u>102</u>
<u>Shale</u>	<u>102</u>	<u>160</u>
<u>Shales</u>	<u>160</u>	<u>210</u>
<u>Sandy shale</u>	<u>210</u>	<u>250</u>
<u>fine sand</u>	<u>250</u>	<u>290</u>

Information upon completion of well:

(1) Diameter 3 inches.
(2) Total Depth 275 feet.
(3) Water Level 95 feet below top of ground.
(4) Cased to 16.8, Size 3
(5) Screen: Size _____, Length _____
(6) Were any formations sealed against pollution?
 yes, no.

CODED

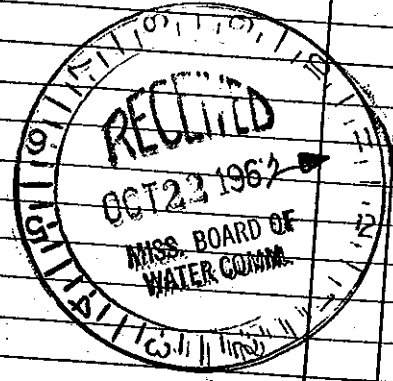

If YES depth of formation _____
Why _____
Drillers Remarks: _____

Well No.