

LAND.

MISSISSIPPI BOARD OF WATER COMMISSIONERS

A56
1-8-63

WATER WELL DRILLERS LOG

CODED

Date: 1-8, 1963, Driller: McDONALD & HILL, Inc. County: Laud.

(Name)

(1) Owner of Land: Martin E. Dooley
(Name)
Rt #1 Collinsville
(Address)

(2) Location: 21 8 14
1/4, 1/4, Sec. T. R.
15 miles SW of Neesh.
(distance) (direction) (Nearest Town)

(3) Topography: ✓
(Hilly) (Flat) (Level)

(4) Purpose of Well: Domestic
(Domestic Irrigation, Municipal, Industrial, Other)

Description & Color of Materials
Sand, Clay, Red Clay, Shell, etc.

Thick-
ness
Feet

Depth
Feet

<u>Clay</u>	<u>0</u>	<u>12</u>
<u>Shale</u>	<u>12</u>	<u>85</u>
<u>Sand</u>	<u>85</u>	<u>103</u>
<u>Shale</u>	<u>103</u>	<u>388</u>
<u>Sand</u>	<u>388</u>	<u>410</u>

Information upon completion of well:

(1) Diameter: 3 inches.
410

(2) Total Depth: _____ feet.


(3) Water Level: 45 feet below top of ground.

(4) Cased to: 168, Size: 3

(5) Screen: Size _____, Length _____

(6) Were any formations sealed against pollution?
_____ yes, _____ no.

CODED

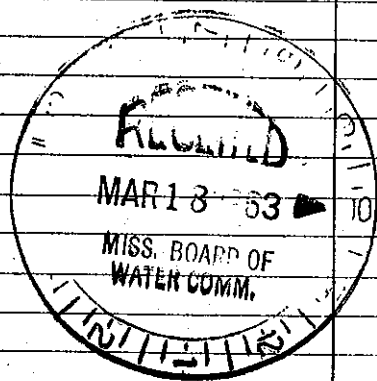

If YES depth of formation _____

Why _____

Drillers Remarks: _____

Well No.

(Use Back Side)

Retain this copy for your office files.