

BOARD OF WATER COMMISSIONERS

WATER WELL DRILLERS LOG

CODED

LAUD.
A 57
7-11-64

Date: 7. 11, 1964, Driller: M^o Donald & Hill, Inc Lumberville
(Name)


(1) Owner of Land: <u>W.E. BILLETTRIDGE</u> (Name)	Description & Color of Materials Sand, Clay, Red Clay, Shell, etc.	Thick- ness Feet	Depth Feet
<u>R#2 COLLINSVILLE</u> (Address)	<u>SANDY CLAY</u>	<u>0</u>	<u>58</u>
(2) Location: <u>1/4, 1/4, Sec. 8 14</u> _____ miles _____ of _____ (distance) (direction) (Nearest Town)	<u>SHALE ST LIGNITE</u>	<u>58</u>	<u>190</u>
(3) Topography: <u>X</u> (Hilly) (Flat) (Level)	<u>SAND</u>	<u>190</u>	<u>230</u>
(4) Purpose of Well: <u>DOMESTIC</u> (Domestic Irrigation Municipal, Industrial, Other)	<u>SANDY SHALE</u>	<u>230</u>	<u>280</u>

Information upon completion of well:

- (1) Diameter 4" inches.
- (2) Total Depth 280' feet.
- (3) Water Level 138' feet below top of ground.
- (4) Cased to 168', Size 4"
- (5) Screen: Size _____, Length _____
- (6) Were any formations sealed against pollution?
_____ yes, _____ no.

If YES depth of formation 1 = 505 B 21
Why 165 = 1" PIPE
Drillers Remarks: 170 = 14 = 3 WIRE
1 = 4 X 1 WELL SEAL
1 = 4 X 6 NIPPLE

CODED

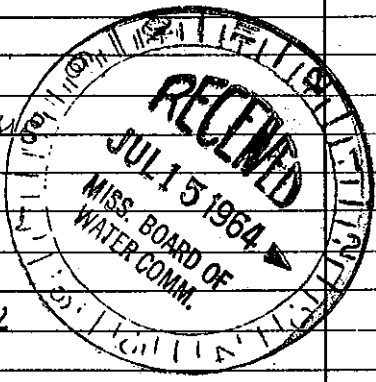

Well No.

(Use Back Side)

Mail this copy to Board of Water Commissioners 429 Miss. St. Jackson, Miss