

LAUDERDALE

A 2009

5/25/76

MISSISSIPPI BOARD OF WATER COMMISSIONERS

416 North State Street
Jackson, Mississippi 39201

WATER WELL DRILLERS LOG

5.25.76

McDONALD + HILL

Laurel

date well completed

firm name

county well located

LANDOWNER:

JAMES E LIVINGSTON

R#1 COLLINSVILLE

(mailing address)

WELL LOCATION:

sec. 27 T. 8 N. R. 14 E

2 miles NORTH of COLLINSVILLE
(distance) (direction) (nearest town)

WELL PURPOSE: FORTH
(home, irrigation, municipal, industrial)

WELL COMPLETION DATA:

- (1) diameter (inches) 4"
- (2) total depth (feet) 160'
- (3) static water level (feet) 92' below top of ground.
- (4) casing PVC 110' (material) (depth)
4" (size) If telescope see back.
- (5) screen (length) (depth to top)
(size) (material)
- (6) pump (HP) (yield gpm)
E (type power)
- (7) electric log (yes or no)
(organization running log)
- (8) how well bottom plugged OPEN

description of formations encountered

from to

Clay sand 0 35

sand 35 42

shale 42 68


Course sand 68 89

Lignite sh. shale 89 95

shale 95 126

hardy shale 126 140

fine sand 140 160

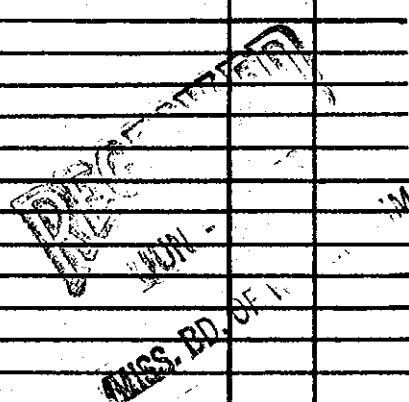

DRILLERS REMARKS: