

LAUDERDALE  
A 2071

MISSISSIPPI  
BOARD OF WATER COMMISSIONERS  
416 North State Street  
Jackson, Mississippi 39201

WATER WELL DRILLERS LOG

date well completed DEC 19 18 WIKEY POOKE LAUDERDALE  
firm name county well located

LANDOWNER:  
NORMAN A MOSLEY  
Collinsville MS 39325  
(mailing address)

WELL LOCATION:  
sec. 15 T. 8 S. R. H W.  
3 miles E of Collinsville  
(distance) (direction) (nearest town)

WELL PURPOSE: HOME  
(home, irrigation, municipal, industrial)

WELL COMPLETION DATA:

(1) diameter (inches) 2 1/2

(2) total depth (feet) 230'

(3) static water level (feet) 70 below top of ground.

(4) casing 2 1/2 100'  
(material) (depth)  
if telescope see back.  
(size)


(5) screen \_\_\_\_\_  
(length) (depth to top)  
(size) (material)

(6) pump 1 1/2 5  
(HP) (yield gpm)  
220  
(type power)

(7) electric log \_\_\_\_\_  
(yes or no)  
(organization running log)

(8) how well bottom plugged OPEN

description of formations encountered	from	to
<del>2-3'</del> Hill sand	0	33
gray shell	33	36
gray sand	36	68
gray shell	68	165
sandy shell	165	195
fine sand	195	206
course sand	206	230
10" rock	at	128'

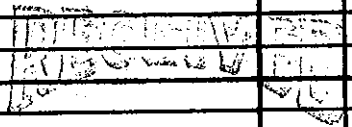

Department of Natural Resources  
Bureau of Land & Water Resources

DRILLERS REMARKS: old pump  
+ TANK