

LAUD.

MISSISSIPPI BOARD OF WATER COMMISSIONERS

B5

WATER WELL DRILLERS LOG

8-22-60

Date: Aug 22 19 60, Driller: R B Nicholas County: Neshoba

(1) Owner of Land: James Kerrand
 (Name)
Christal Miss.
 (Address)

(2) Location: 1/4, 24 8N 15E
 (distance) 11 miles North, of Meridian
 (direction) (Nearest Town)

(3) Topography: Hilly
 (Hilly) (Flat) (Level)

(4) Purpose of Well: Domestic
 (Domestic Irrigation
 Municipal, Industrial, Other)

Description & Color of Materials Sand, Clay, Red Clay, Shell, etc.	Thick- ness Feet	Depth Feet
<u>Sand & Clay</u>		<u>1.60</u>
<u>blue dirt</u>		<u>60 to 80</u>
<u>Black</u>	<u>180</u>	<u>220</u>
<u>Hard rock</u>	<u>220</u>	<u>222</u>
<u>mix sand</u>	<u>222</u>	<u>230</u>
<u>fine water sand</u>	<u>230</u>	<u>255</u>

Information upon completion of well:

(1) Diameter 2" inches.

(2) Total Depth 255 feet.

(3) Water Level 140 feet below top of ground.

(4) Cased to 167, Size 2"


(5) Screen: Size Open, Length _____

(6) Were any formations sealed against pollution?
 _____ yes, no.

If YES depth of formation _____

Why _____

Drillers Remarks: good well
open type

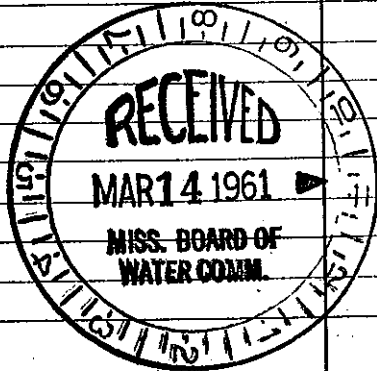

(Use Back Side)

Well No.

Mail this copy to Board of Water Commissioners 429 Miss. St. Jackson, Miss