

BOARD OF WATER COMMISSIONERS

WATER WELL DRILLERS LOG

LAUD.
B6
11-25-60

Date: Nov. 25, 1960, Driller: Perry Drilling Co. County Lauderdale
(Name)

	Description & Color of Materials Sand, Clay, Red Clay, Shell, etc.	Thick- ness Feet	Depth Feet
(1) Owner of Land: <u>J. E. White</u> (Name)	<u>Surface clay + yellow mud</u>	<u>44'</u>	<u>44'</u>
<u>Obadiah, Miss</u> (Address)	<u>Blue mud</u>	<u>44'</u>	<u>265'</u>
(2) Location: <u>8N15E</u> <u>1/4, 1/4, Sec. 11 T. R.</u>	<u>Layers sand + mud</u>	<u>265'</u>	<u>318'</u>
<u>2</u> miles <u>North</u> of <u>Obadiah</u> (distance) (direction) (Nearest Town)			
(3) Topography: <u>Level</u> (Hilly) (Flat) (Level)			
(4) Purpose of Well: <u>Domestic</u> (Domestic Irrigation Municipal, Industrial, Other)			

Information upon completion of well:

(1) Diameter 3" inches.

(2) Total Depth 318' feet.

(3) Water Level 150' feet below top of ground.

(4) Cased to 168', Size 3"


(5) Screen: Size open well, Length _____

(6) Were any formations sealed against pollution?
no

If YES depth of formation 265'

Why Casing set in firm

Drillers Remarks: _____

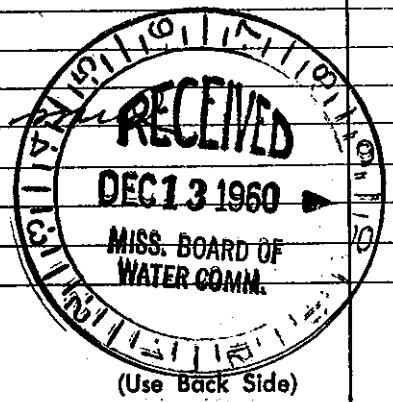

Well No. _____

Retain this copy for your office files.