

LAUD.

MISSISSIPPI BOARD OF WATER COMMISSIONERS

B 9
10-31-60

WATER WELL DRILLERS LOG

5 5

Date: Oct. 31, 1960, Driller: Terry Drilling Co. County Lauderdale
(Name)

(1) Owner of Land:	Description & Color of Materials Sand, Clay, Red Clay, Shell, etc.	Thick- ness Feet	Depth Feet
C. E. Parker (Name)	Red Clay + White Sand	0	22'
Center Hill, Miss. (Address)	Yellow Sand	22'	66'
(2) Location: 1/4, 1/4, Sec. 21 T. R. 8 N 15 E	Gray dirt	66'	110'
1/4 miles North East of Center Hill (distance) (direction) (Nearest Town)	Layer Gray dirt sand	110'	169'
(3) Topography: (Hilly) (Flat) (Level)	Gray dirt	169'	192'
(4) Purpose of Well: Domestic (Domestic Irrigation Municipal, Industrial, Other)	Layer dirt & sand	192'	235'
	Gray sand	235'	256'


Information upon completion of well:

- (1) Diameter 3 inches.
- (2) Total Depth 256 feet.
- (3) Water Level 125 feet below top of ground.
- (4) Cased to 168, Size 3
- (5) Screen: Size open, Length
- (6) Were any formations sealed against pollution?
yes, no.

If YES depth of formation 169'

Why set on tough formation

Drillers Remarks:

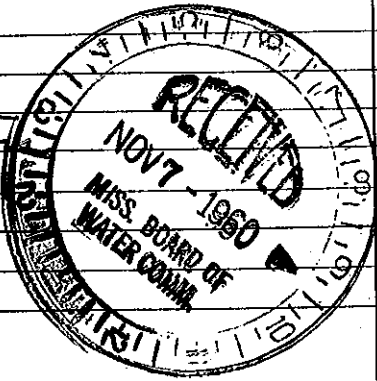

Well No.

(Use Back Side)

Mail this copy to Board of Water Commissioners 429 Miss. St. Jackson, Miss