

L.A.U.D.  
B10

# WATER WELL DRILLERS LOG

6

Date: ~~6/12/64~~ 19 64, Driller: Bob Williams County Lauderdale  
(Name)

(1) Owner of Land: J.M. Snowden  
(Name)

Rt. 2 - Box 154 Mendon  
(Address)

(2) Location: north 1/2 of SE  
1/4, 1/4, Sec. 21 T8 R15,  
11 miles north of Mendon  
(distance) (direction) (Nearest Town)

(3) Topography: Flat  
(Hilly) (Flat) (Level)

(4) Purpose of Well: Domestic  
(Domestic Irrigation  
Municipal, Industrial, Other)

Description & Color of Materials Sand, Clay, Red Clay, Shell, etc.	Thick- ness Feet	Depth Feet
<u>Blue clay (soft)</u>	<u>18</u>	<u>1-18</u>
<u>White sand</u>	<u>4</u>	<u>18-22</u>
<u>Blue clay</u>	<u>63</u>	<u>22-85</u>
<u>Gray sand</u>	<u>15</u>	<u>85-100</u>
<u>Hard Blue rock</u>	<u>2</u>	<u>100-102</u>
<u>Gray sand</u>	<u>35</u>	<u>102-137</u>

### Information upon completion of well:

(1) Diameter 4 inches.

(2) Total Depth 137 feet.

(3) Water Level 40 feet below top of ground.


(4) Cased to 42, Size 4 in.

(5) Screen: Size no, Length \_\_\_\_\_.

(6) Were any formations sealed against pollution?  
 yes, \_\_\_\_\_ no.

If YES depth of formation 1 to 20 ft.  
Why Bad surface water

Drillers Remarks: \_\_\_\_\_  
\_\_\_\_\_  
\_\_\_\_\_

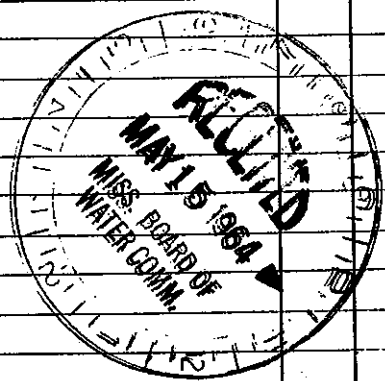

Well No.

(Use Back Side)

Mail this copy to Board of Water Commissioners 429 Miss. St. Jackson, Miss.