

LAUD, MISSISSIPPI BOARD OF WATER COMMISSIONERS

B11

WATER WELL DRILLERS LOG

9-17-64

Date: 9.17, 1964, Driller: M^cDonald & Hill^{In} County _____

(Name)

| (1) Owner of Land | Description & Color of Materials Sand, Clay, Red Clay, Shell, etc. | Thick- ness Feet | Depth Feet |
|--|---|------------------------|---------------|
| ALTON JOYNER (Name) | SAND ST CLAY | 0 | 15 |
| Rt #2, Meridian (Address) | SHALE | 15 | 80 |
| (2) Location: 1/4, 1/4, Sec 21 T. R. 8N 15E | SHALE ST ROCK | 80 | 100 |
| 1/2 miles West, of Carter H. (distance) (direction) (Nearest Town) | SHALE | 100 | 250 |
| (3) Topography: X (Hilly) (Flat) (Level) | SANDy SHALE ST SAND | 250 | 270 |
| (4) Purpose of Well: DOMESTIC (Domestic Irrigation Municipal, Industrial, Other) | | | |

Information upon completion of well:

(1) Diameter: 3 3/8 inches. TEST HOLE

(2) Total Depth: 270' feet.

(3) Water Level: 130' feet below top of ground.

(4) Cased to: 157', Size: 4"


(5) Screen: Size _____, Length _____.

(6) Were any formations sealed against pollution?
_____ yes, _____ no.

If YES depth of formation _____

Why _____

Drillers Remarks: _____

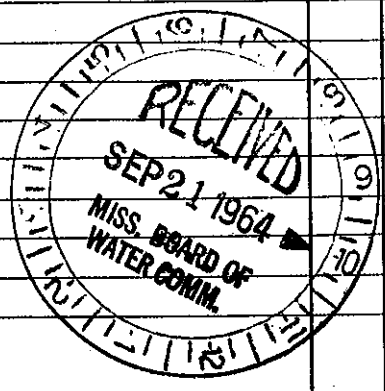

(Use Back Side)

Well No.

Mail this copy to Board of Water Commissioners 429 Miss. St. Jackson, Miss: